


T.35 S. R.2 & 3 W.W.M.

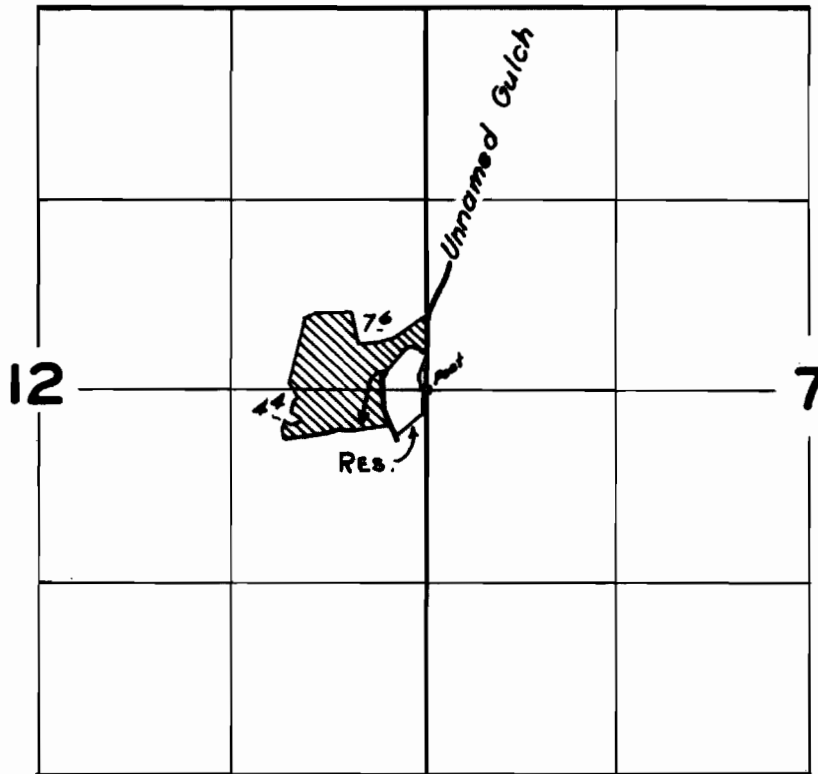

FINAL PROOF SURVEY
UNDER

Application No. ^{R-26680} ~~26681~~ Permit No. ^{R-1285} ~~208.90~~
IN NAME OF

CASPAR & KATHARINA MEYER

Surveyed *7 April* 1960, by *R. Jackson*