


T.35 S. R.2 & 3 W.W.M.

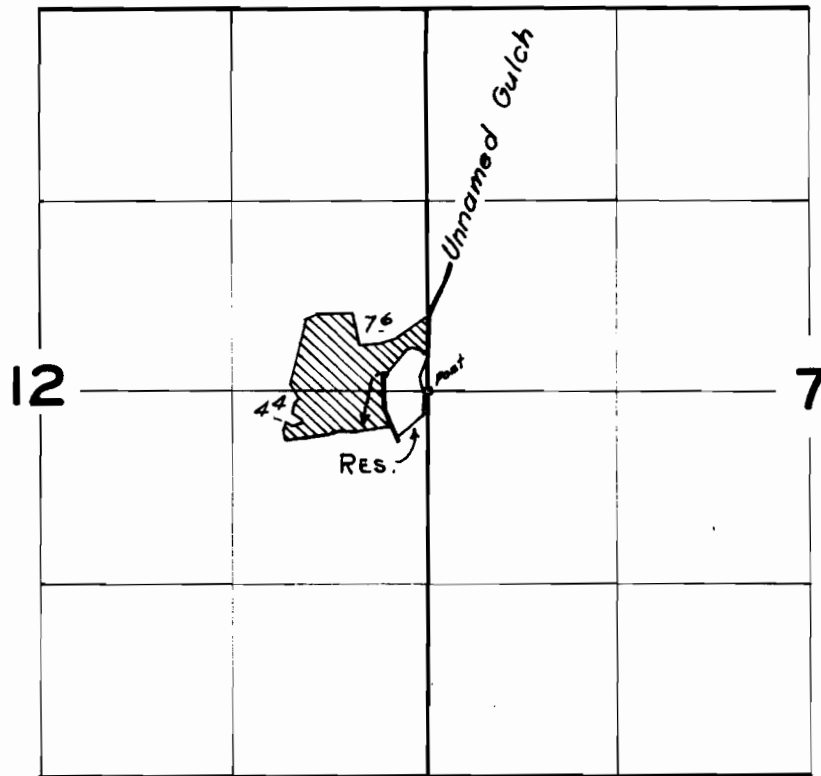

FINAL PROOF SURVEY  
UNDER

Application No. R-26680 Permit No. R-1285  
26681 20890  
IN NAME OF

CASPAR & KATHARINA MEYER

Surveyed 7 April, 1960, by R. Jackson