


T.36S. R.4 W.W.M.

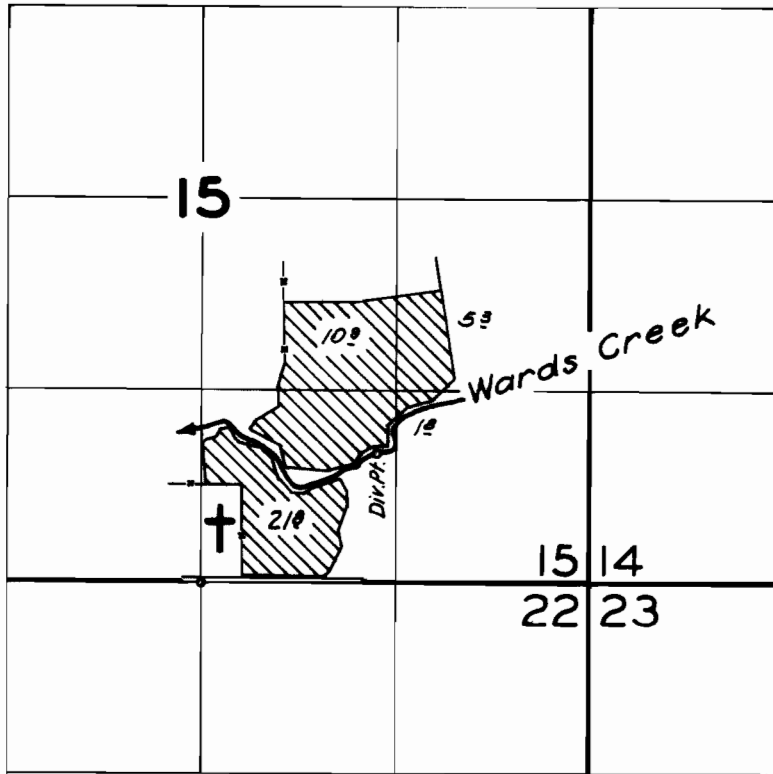

**FINAL PROOF SURVEY**  
UNDER

Application No. 27067. Permit No. 21297.  
IN NAME OF

**CORNELIUS H. TJOELKER**

Surveyed 12 April, 1960, by *R.H. Jackson*