


T.36S.R.3W.W.M.

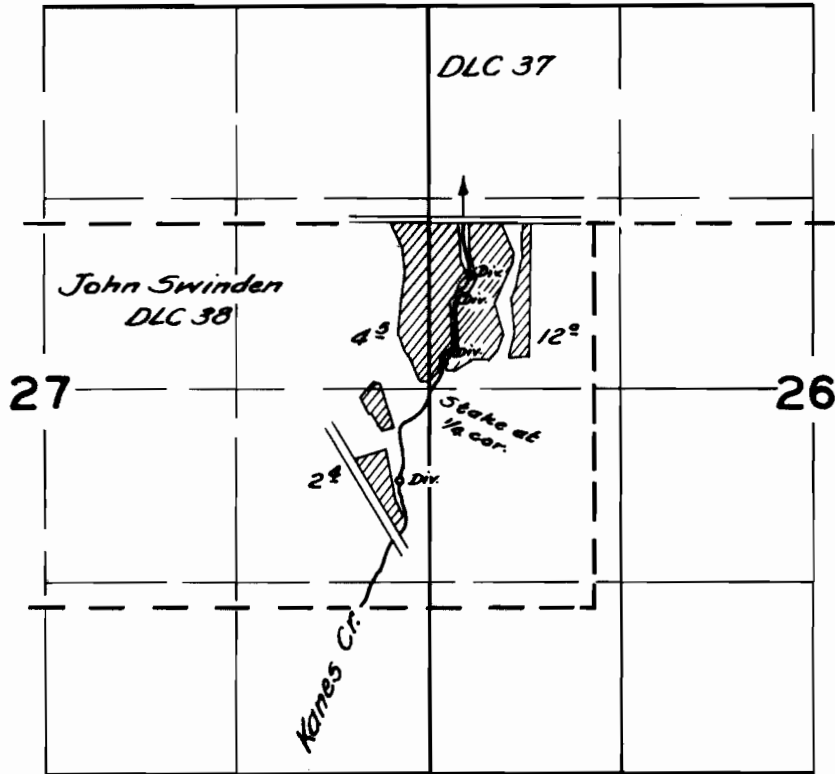

FINAL PROOF SURVEY
UNDER

Application No. 28087... Permit No. 22118...
IN NAME OF

.....*William Foley*.....

Surveyed *April 3, 1960*, by *C.O. Baitek*.....