


T.35 S. R. 2&3 W.W.M.

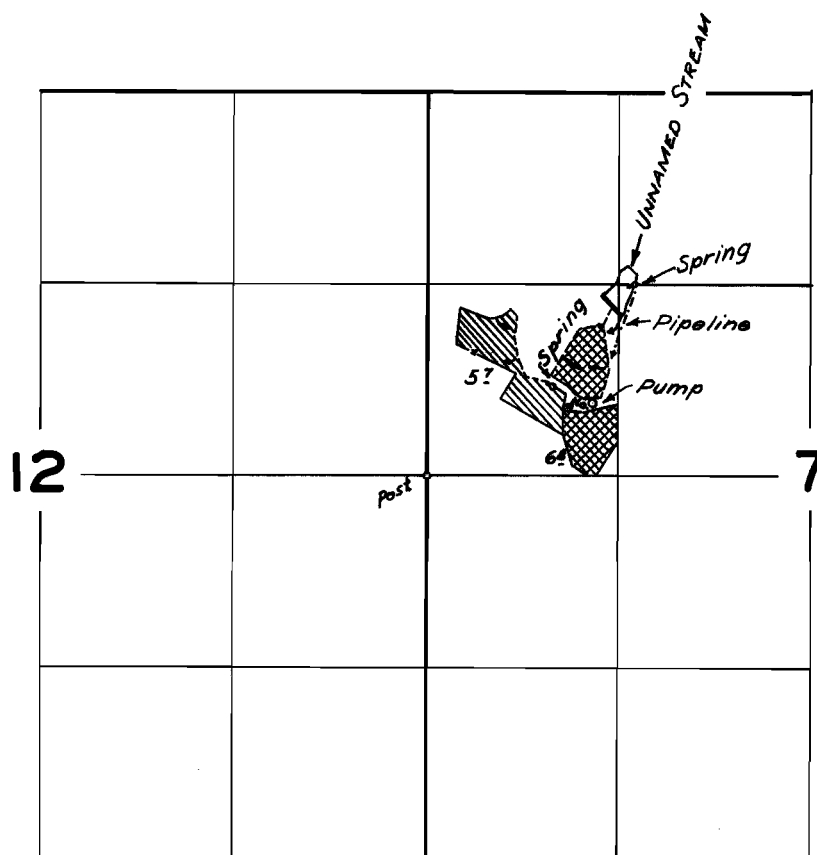

 From Springs
 From Spring & Res.

FINAL PROOF SURVEY
UNDER

27628
R-29319
Application No. 29320... Permit No. 23089...
IN NAME OF

EUGENE L. KIRKHAM

Surveyed 7 April 1960, by 