


T.36S. R.4 W.W.M.

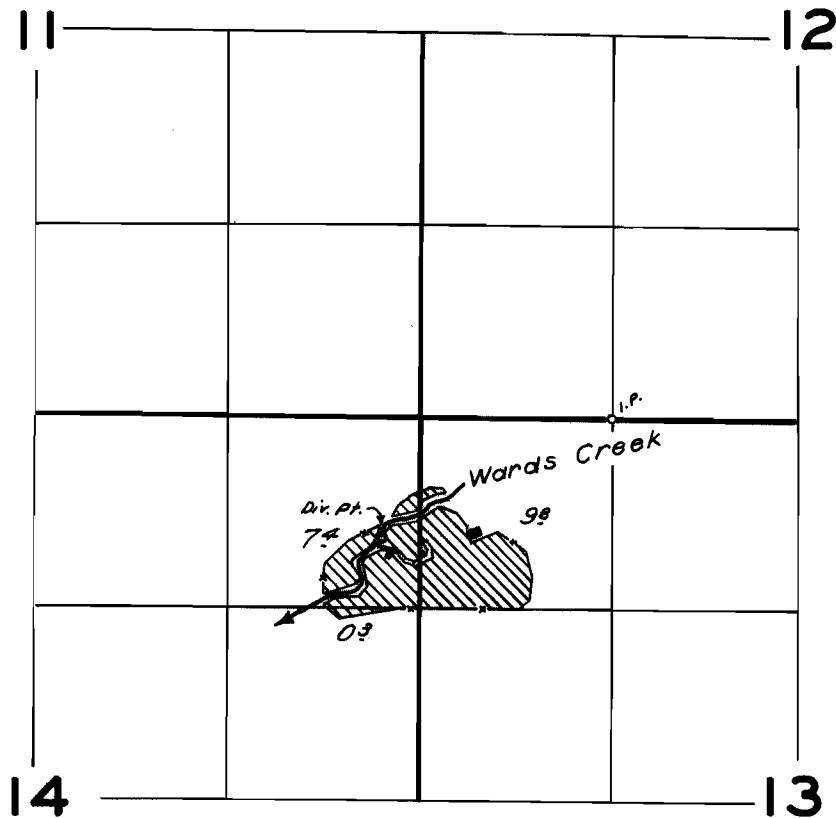

FINAL PROOF SURVEY
UNDER

Application No. 29600. Permit No. 23307
IN NAME OF

JOHN M. MFCABE

Surveyed 14 April 1960, by R. Jackson