


T.38-39S. R.3W.W.M.

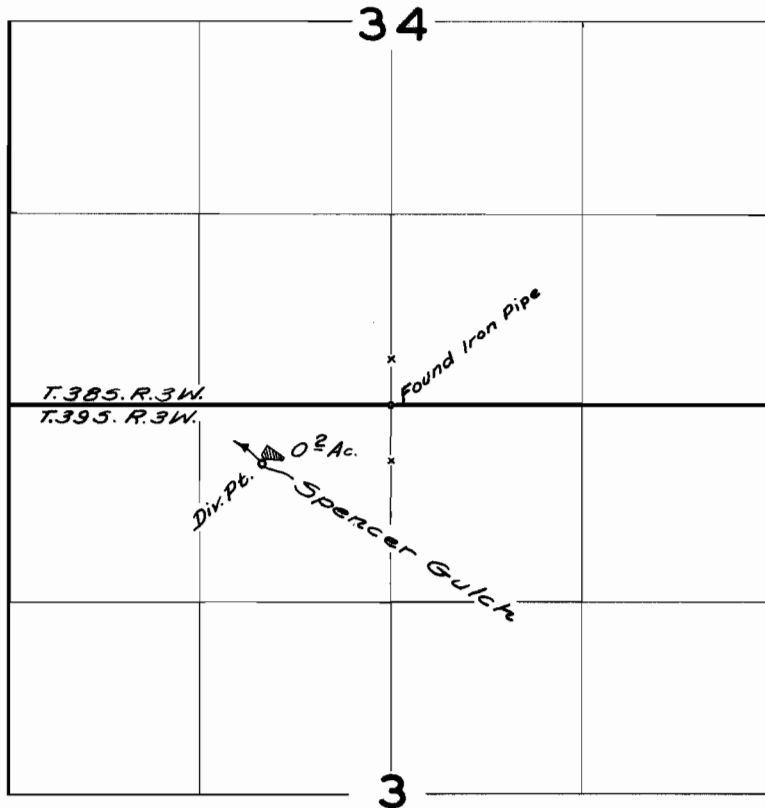

FINAL PROOF SURVEY UNDER

Application No. 29514 Permit No. 23334
IN NAME OF

Harry McAllister

Surveyed April 14 1960, by W. Bartels