


T.35S. R. 2 W.W.M.

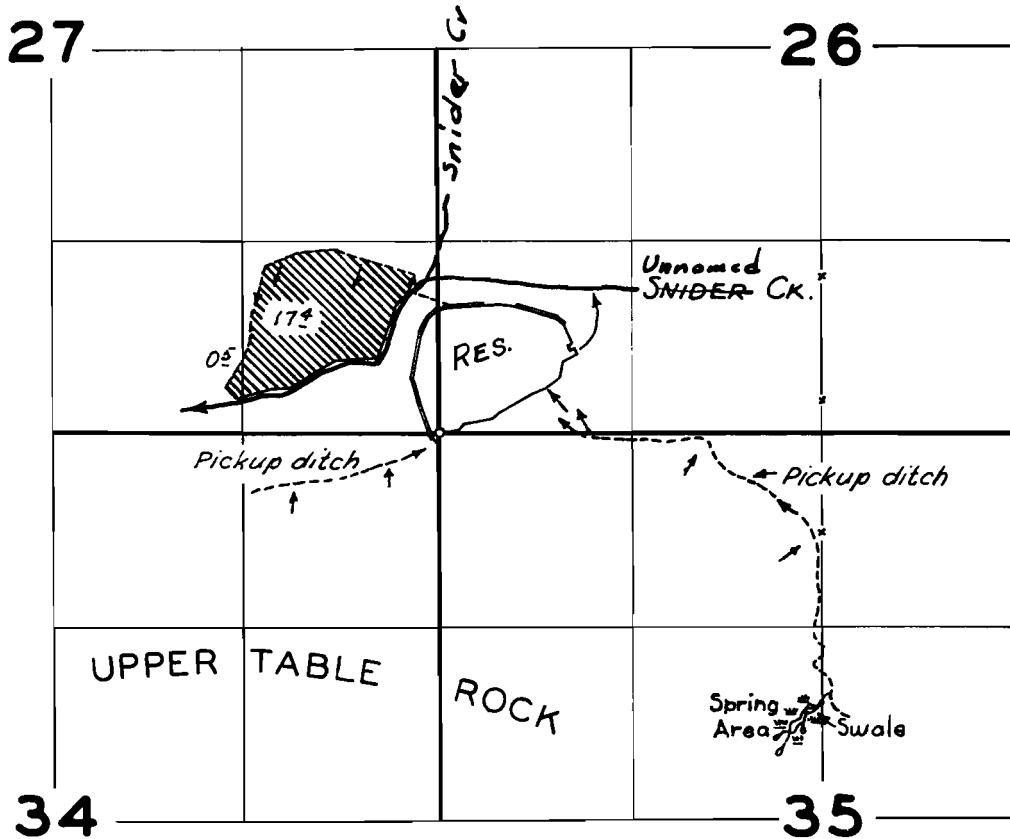

**FINAL PROOF SURVEY**  
UNDER

Application No. R-30110 30111 Permit No. R-1774 23568  
IN NAME OF

VIGGO SKOU

Surveyed 8 April 1960, by R. Jackson