


T.35S. R. 2 W.W.M.

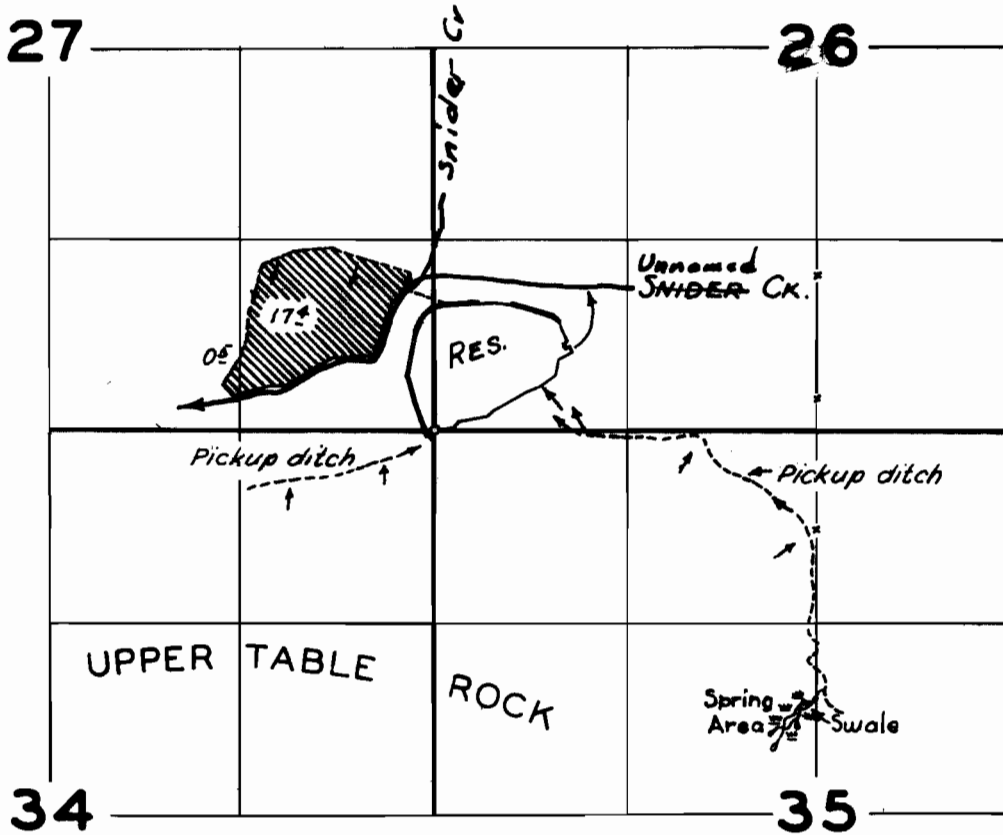

FINAL PROOF SURVEY
UNDER

Application No. ^{R-30110} 30111 Permit No. ^{R-1774} 23568
IN NAME OF

VIGGO SKOU

Surveyed 8 April 1960, by *R. H. Jackson*