


T.40S.R.3W.W.M.

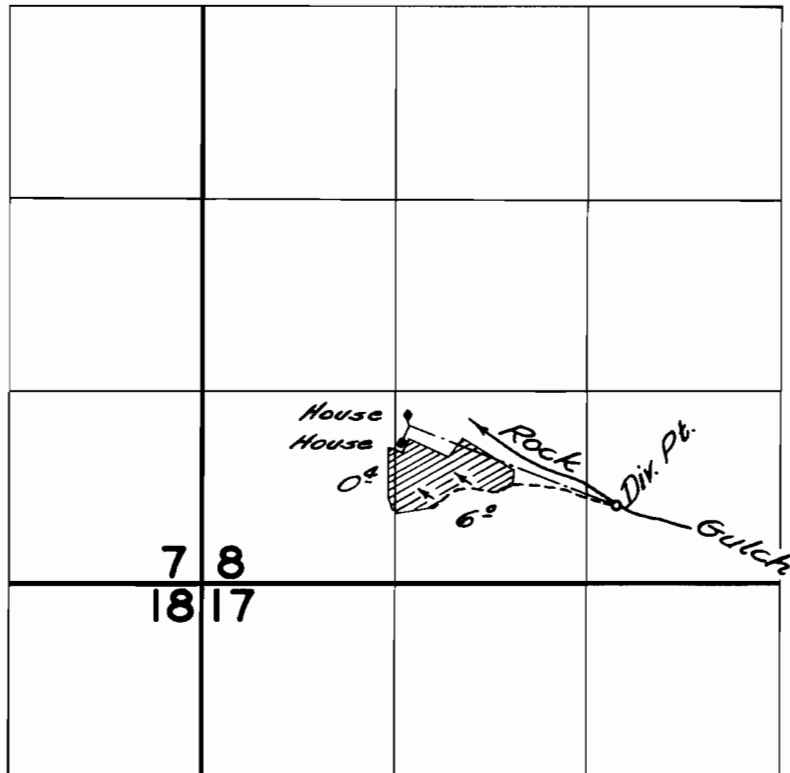

FINAL PROOF SURVEY
UNDER

Application No. *30489*... Permit No. *24429*....
IN NAME OF

.....*E. H. Fossen*.....

Surveyed *April 6*.. 1960, by *C. O. Baith*..