


# T.40 S.R.8 W.W.M.

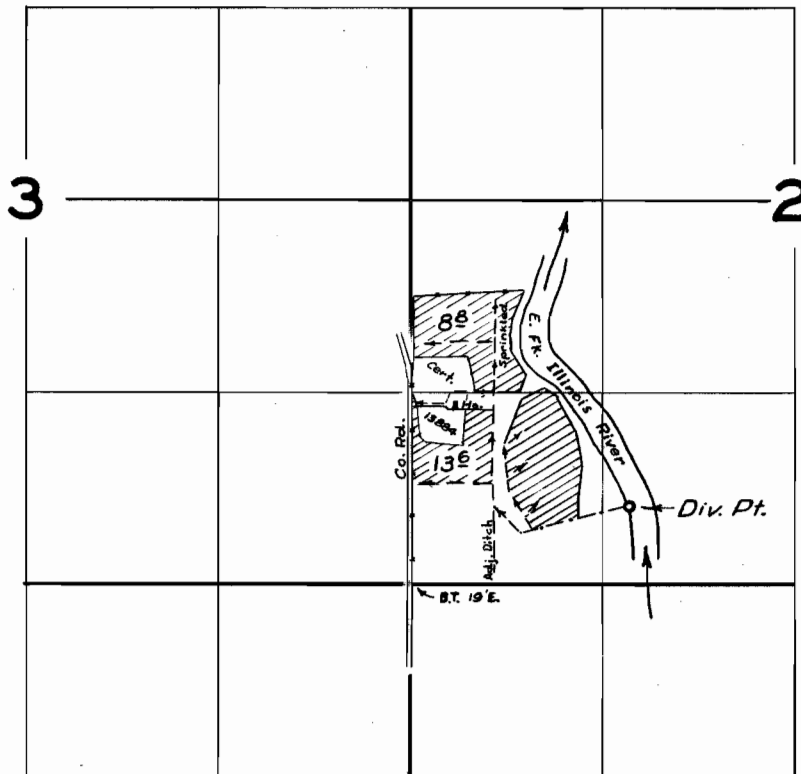

## FINAL PROOF SURVEY UNDER

Application No. 29163 Permit No. 23329  
IN NAME OF

B.F. & Mary R. Randolph

Surveyed 17 July 1959, by m. Bish