


76-310
28335

T. 39S. R. 11E. W.M.

Swan Lake Weeds

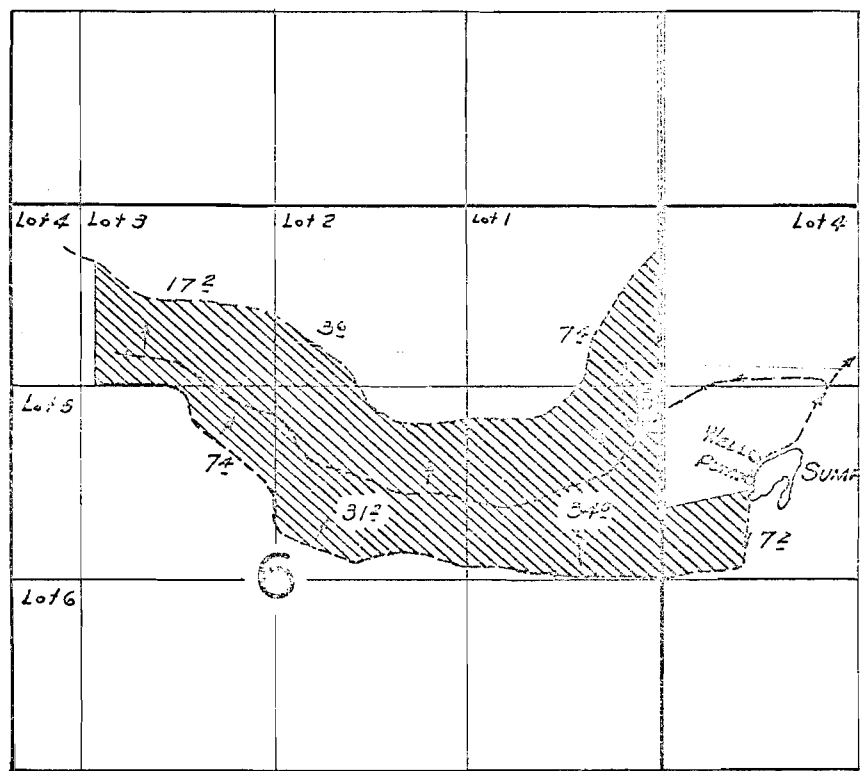

FINAL PROOF SURVEY
UNDER

Application No. U-338. Permit No. U-310.
IN NAME OF

L. L. PORTERFIELD

Surveyed Oct. 29, 1959, by *R. Jackson*