T.16 S. R. 4 W.W.M.

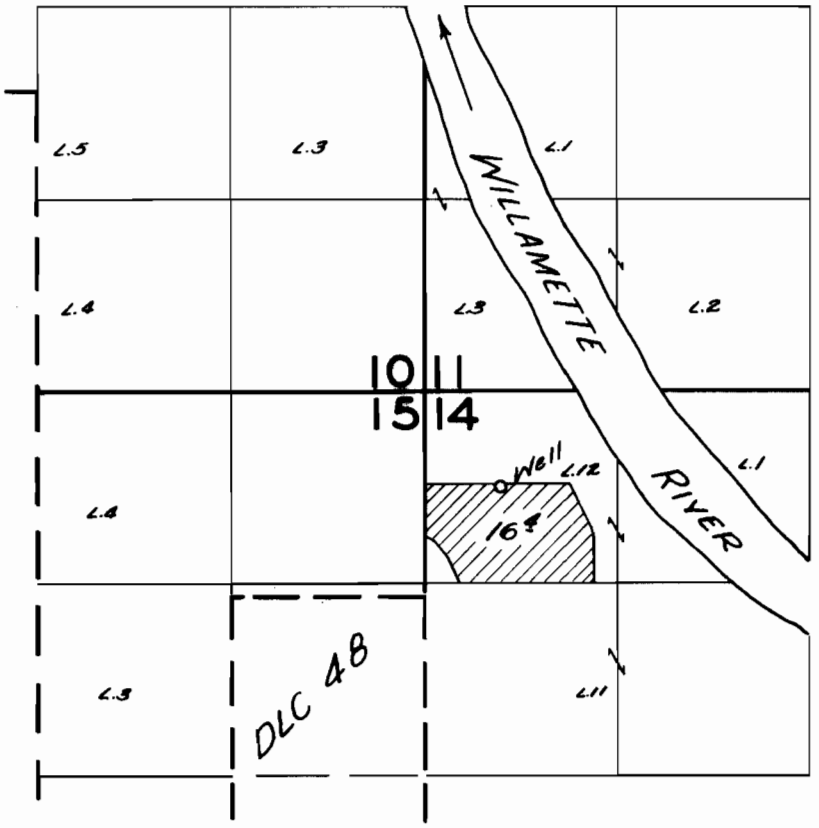

FINAL PROOF SURVEY
UNDER

Application No. G:906 Permit No. G:1088
IN NAME OF

Jesse Harper

Surveyed April 26 1960, by C.O. Bartlett

DBQ-4H-96