


T.18S.R.3W.W.M.

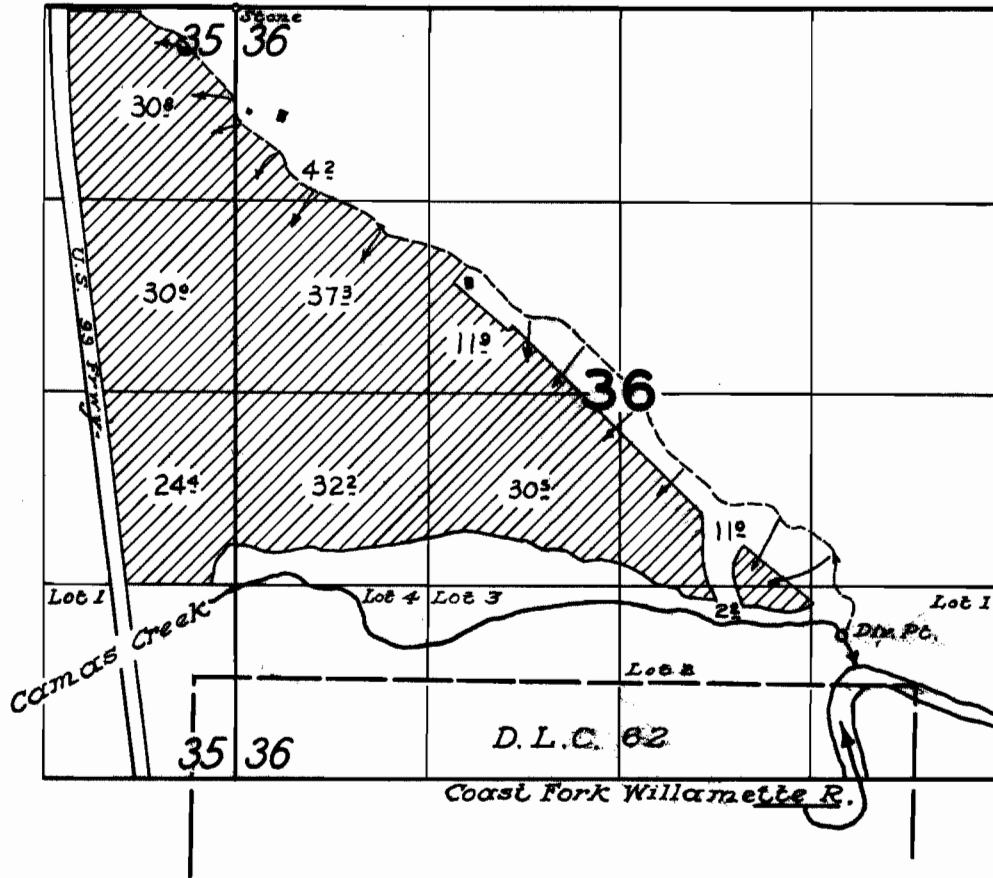

FINAL PROOF SURVEY
UNDER

Application No. 29268. Permit No. 22959
IN NAME OF

T. W. & DORRIS B. JONES

Surveyed April 1, 1959, by M. Bish
May 9 1960, by R. Jackson