


T. 18S. R. 2W. W.M.

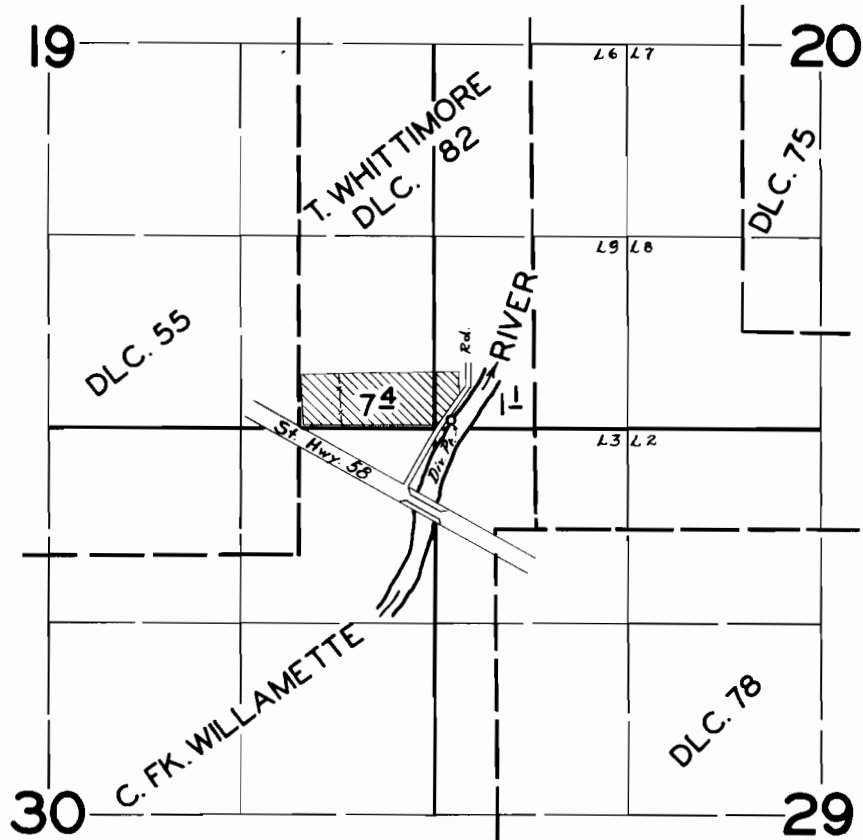

FINAL PROOF SURVEY
UNDER

Application No. 30383 Permit No. 23881
IN NAME OF

J.F. & MINNIE ABBOTT

Surveyed MAR. 26 1959, by M. BISH