


# T.16S.R.5W.W.M.

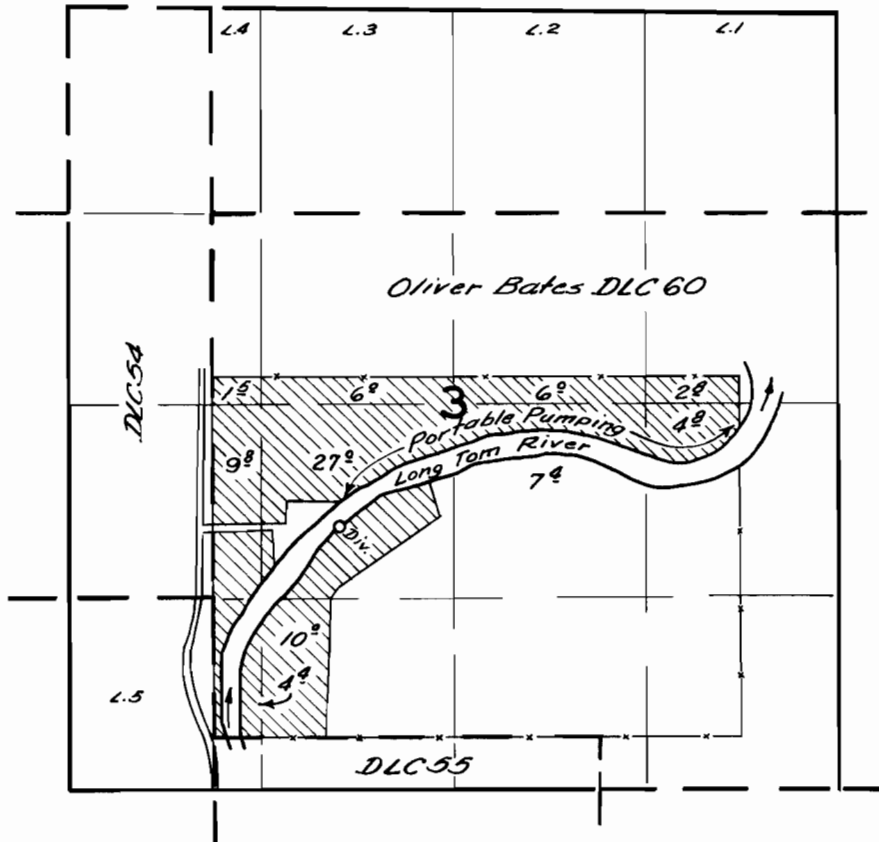

## FINAL PROOF SURVEY UNDER

Application No. 30609... Permit No. 24120...  
IN NAME OF

..... A. G. of CORA JOHNSON .....

Surveyed May 2, 1960, by C. O. Bastin