


T.20 S. R.3 W.W.M.

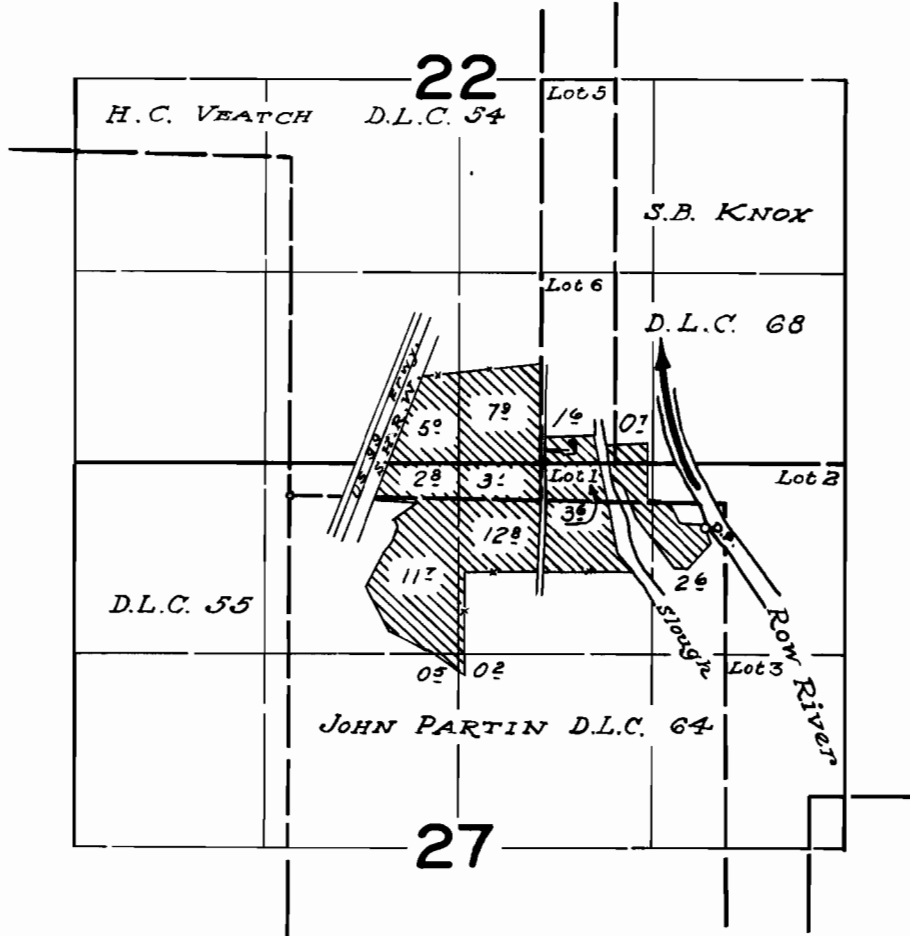

FINAL PROOF SURVEY
UNDER

Application No. 31339 Permit No. 24696
IN NAME OF

A.R. & LILLIE HEMENWAY

Surveyed May 13, 1960, by *R. Jackson*