


T.20 S.R. 1W.W.M.

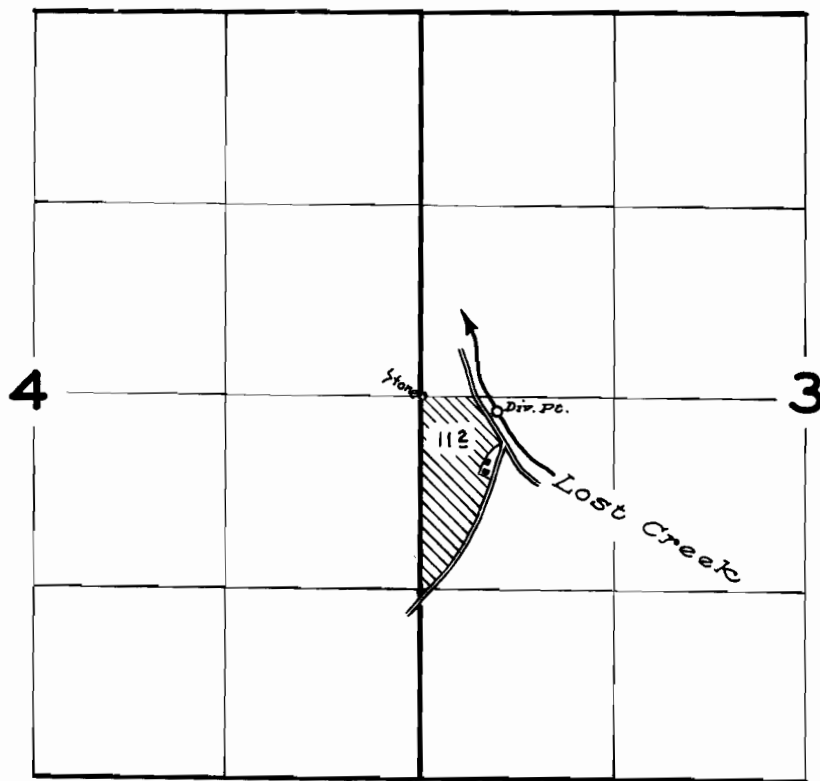

FINAL PROOF SURVEY
UNDER

Application No. 31478. Permit No. 24815.
IN NAME OF

R. L. GRAYSON

Surveyed May 12, 1960, by *R. H. Jackson*