


T.19S. R.1W.&1E.W.M.

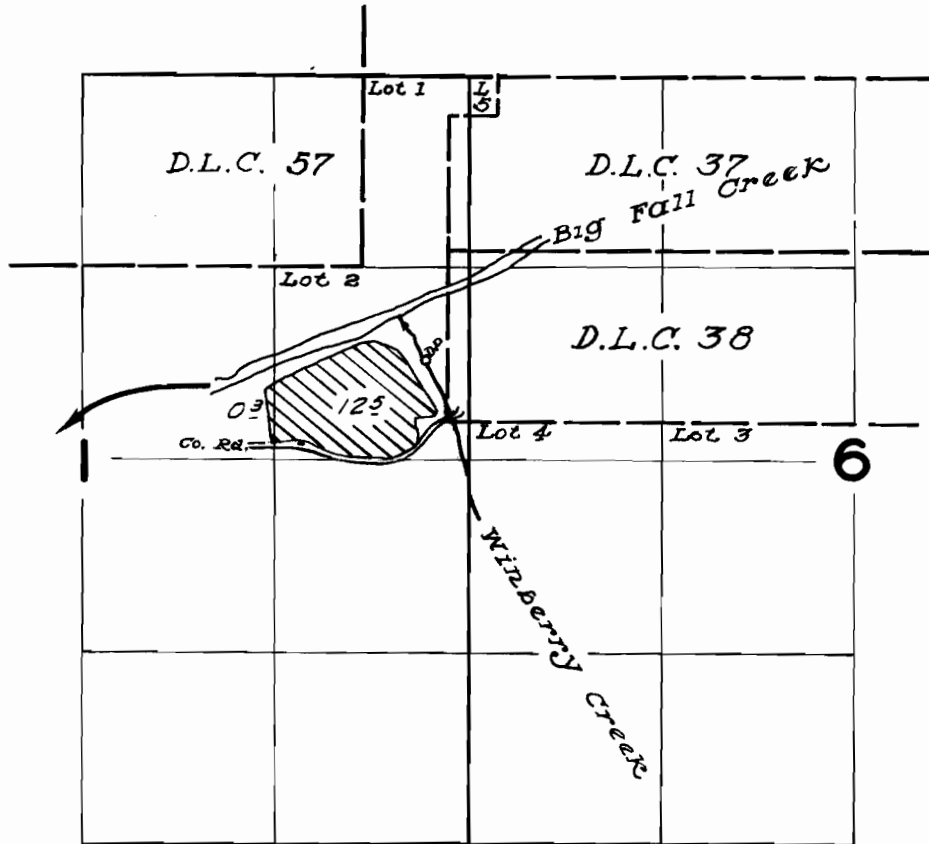

FINAL PROOF SURVEY
UNDER

Application No. 32159... Permit No. 25371...
IN NAME OF

RAYMOND H. BLOOD

Surveyed May 4, 1960, by *RH Jackson*