


T.19S. R.2 W.W.M.

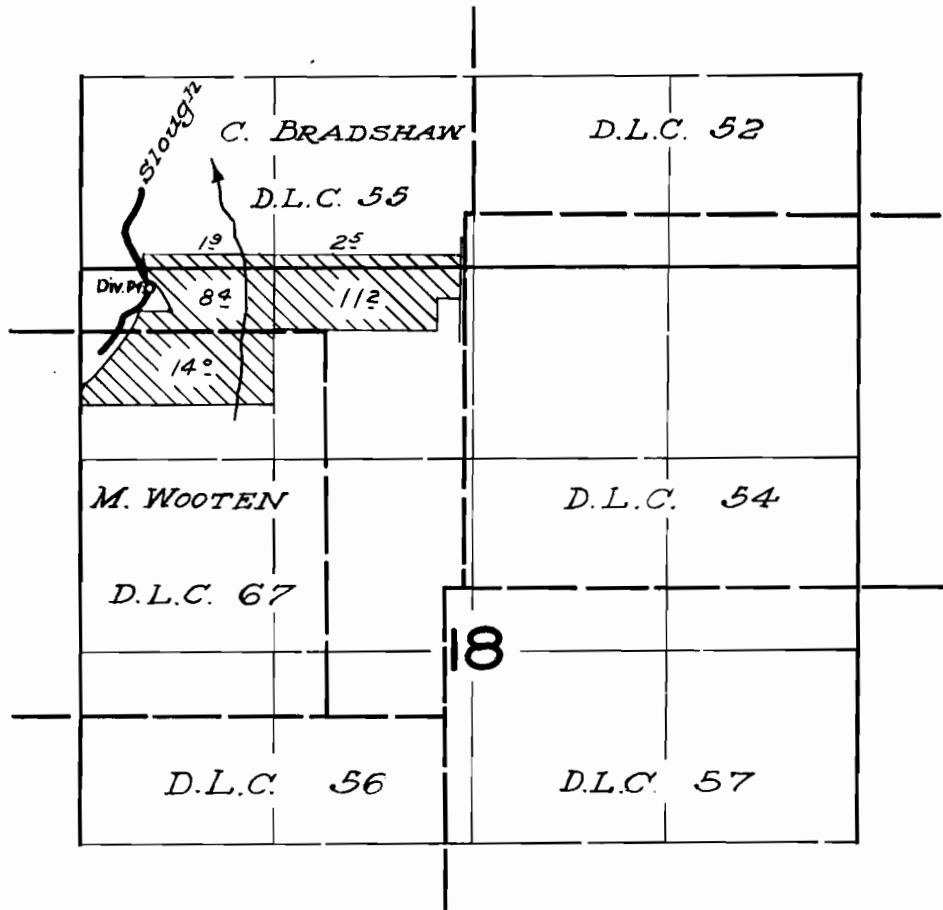

FINAL PROOF SURVEY
UNDER

Application No. 32228.. Permit No. 25426..
IN NAME OF

WAYNE E. & MARGEY BOWERS

Surveyed May 9... 1960., by *R.H. Jackson*