


T.19S.R.3W.W.M.

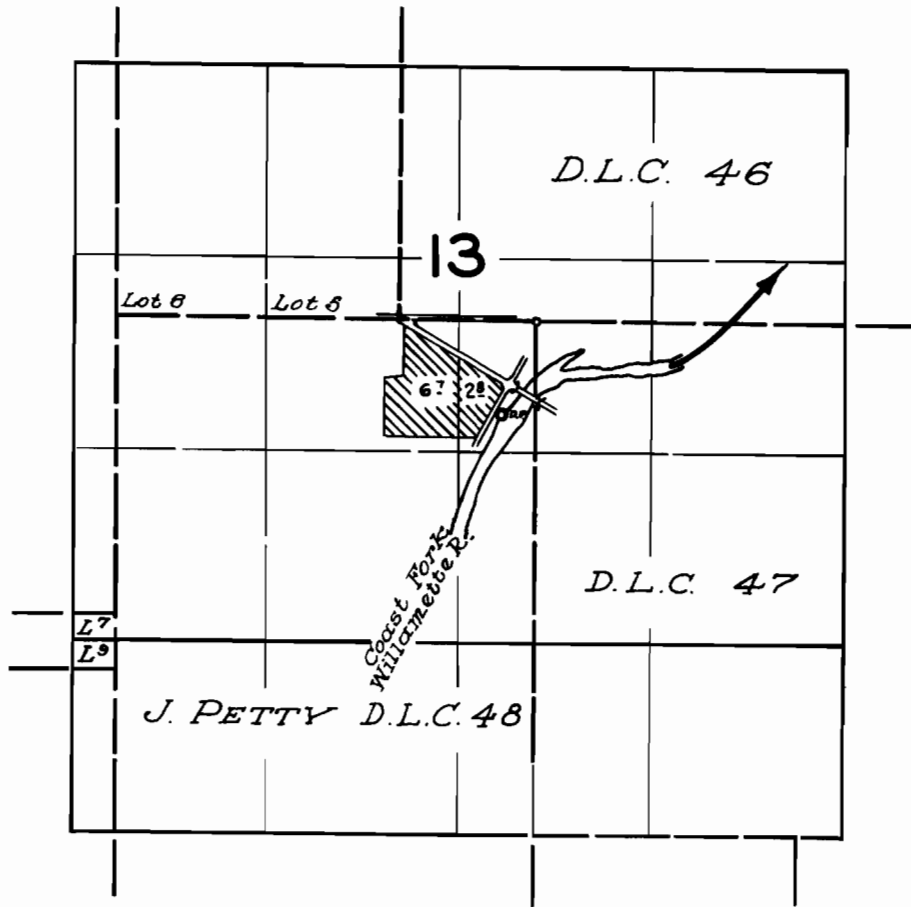

FINAL PROOF SURVEY
UNDER

Application No. 32119... Permit No. 25616...
IN NAME OF

PAUL ROSS

Surveyed May 6, 1960, by *R.H. Jackson*