


T.18S. R. 1 W.W.M.

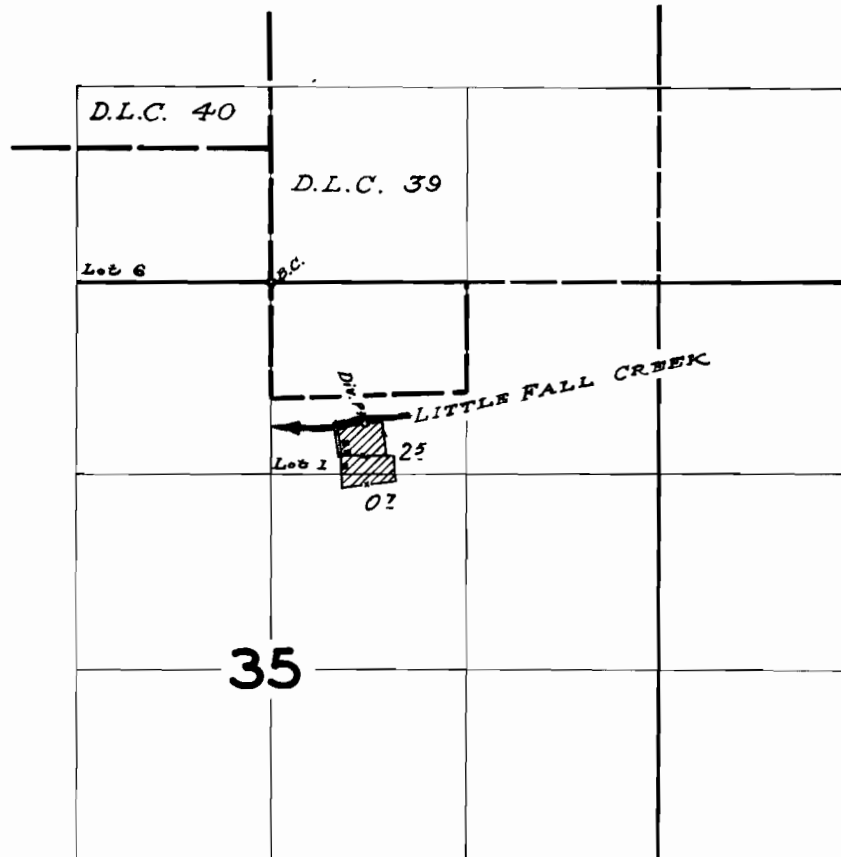

FINAL PROOF SURVEY
UNDER

Application No. 3.24.7.9 Permit No. 25.64.5.
IN NAME OF

WILLIAM MALLORIE

Surveyed May 4, 1960, by R. H. Jackson