


T.8 & 9S.R.11W.W.M.

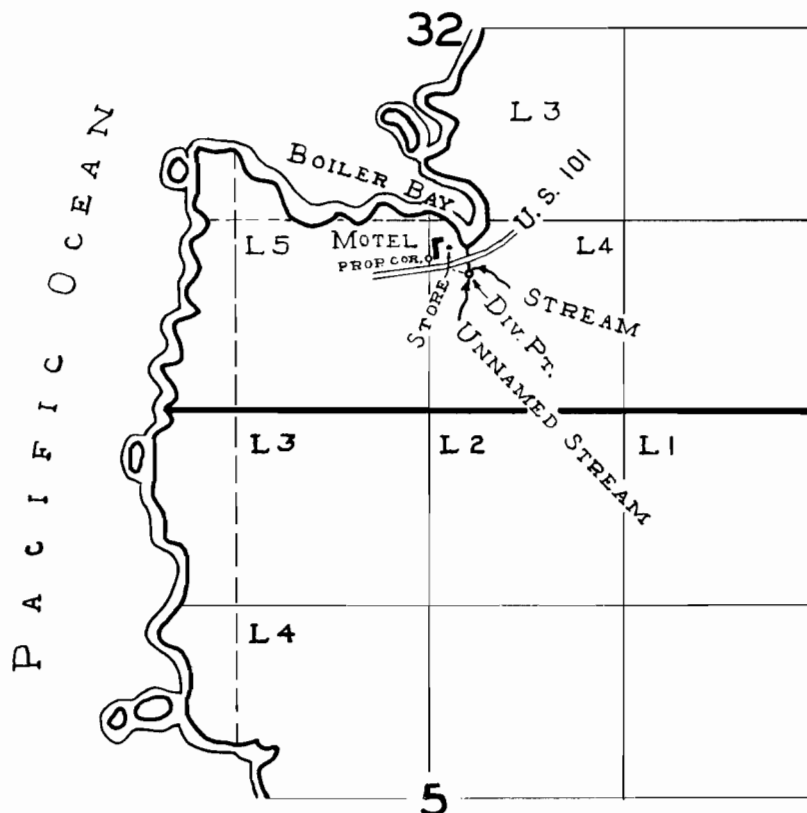

FINAL PROOF SURVEY
UNDER

Application No. 20586. Permit No. 16087.....
IN NAME OF

.....**SAM SMILDE**.....

Surveyed Aug. 11, 1960, by M. BISH.....