


T.8S. R. 11W.W.M.

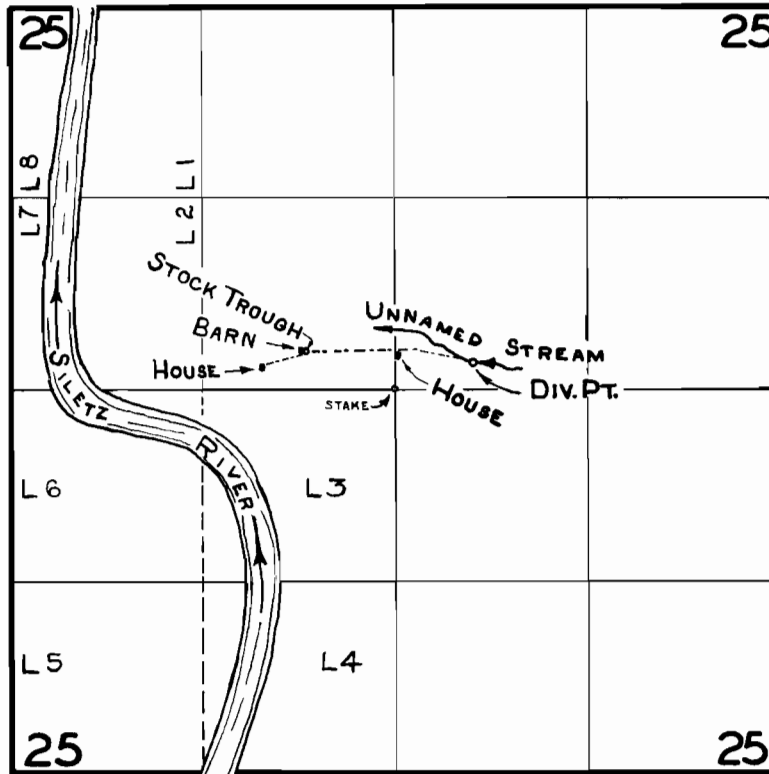

FINAL PROOF SURVEY
UNDER

Application No. 30694... Permit No. 24184...
IN NAME OF

.....FRANK KETOLA.....

Surveyed Aug. 11... 1960, by M. BISH.....