


T.I.S.R.I.W.W.M.

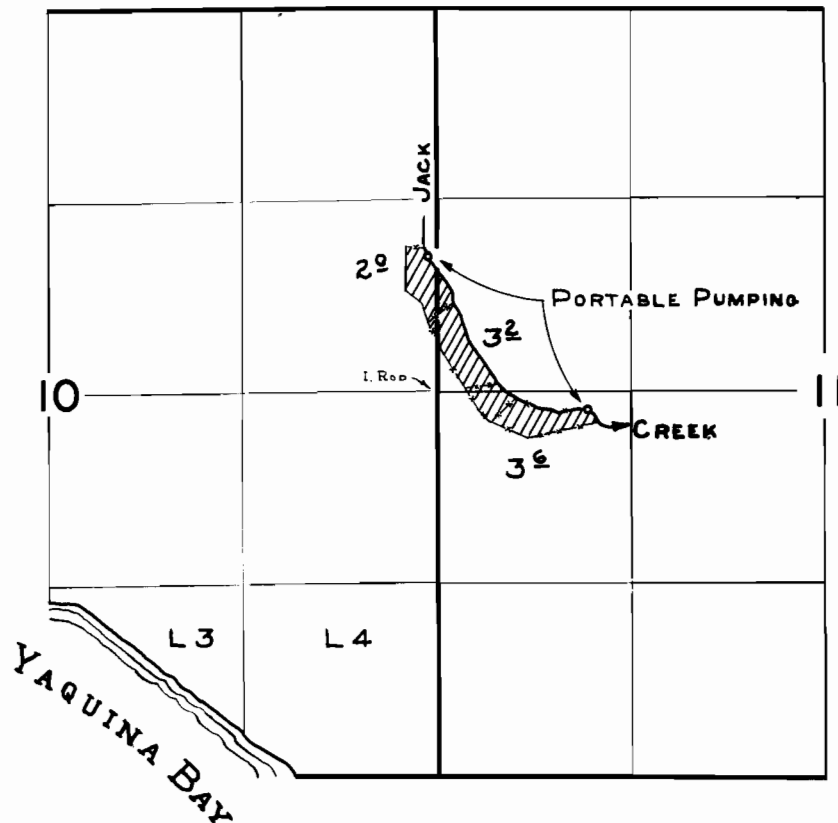

FINAL PROOF SURVEY
UNDER

Application No. 31556... Permit No. 24903...
IN NAME OF

... JOHN ALLEN & EDITH S. POTWIN ...

Surveyed AUG. 18, 1960, by M. BISH