


T.7S. R.11W.W.M.

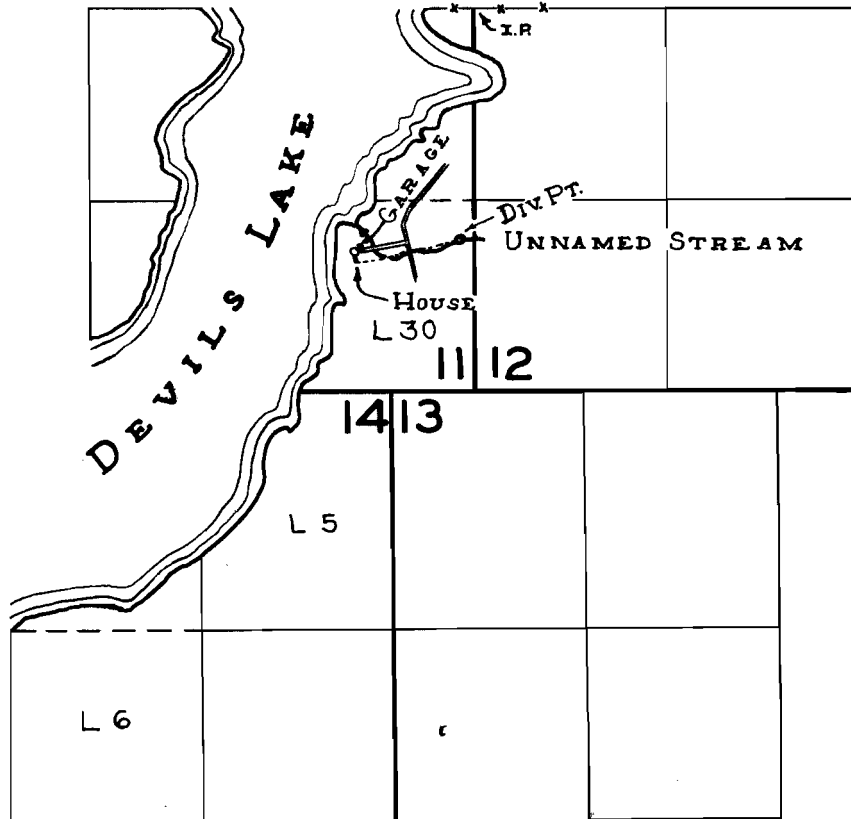

**FINAL PROOF SURVEY**  
UNDER

Application No. 32008. Permit No. 25252...  
IN NAME OF

.....E. RROL C. & FAY P. BRIGGS.....

Surveyed Aug. 10... 1960, by ...M. BISH.....

1960-E

AK