


T.6S. R. 10W.W.M.

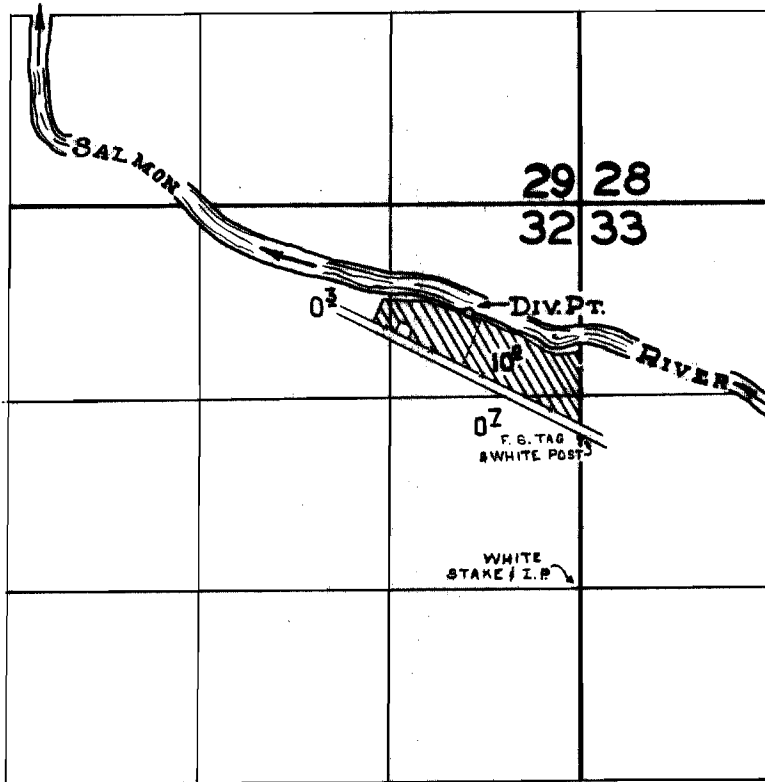

FINAL PROOF SURVEY
UNDER

Application No. 33025.. Permit No. 26110....
IN NAME OF

.....**ELDON W. HERINGER**.....

Surveyed Aug. 9... 1960, by M. BISH.....