


T.10S. R.2W.W.M.

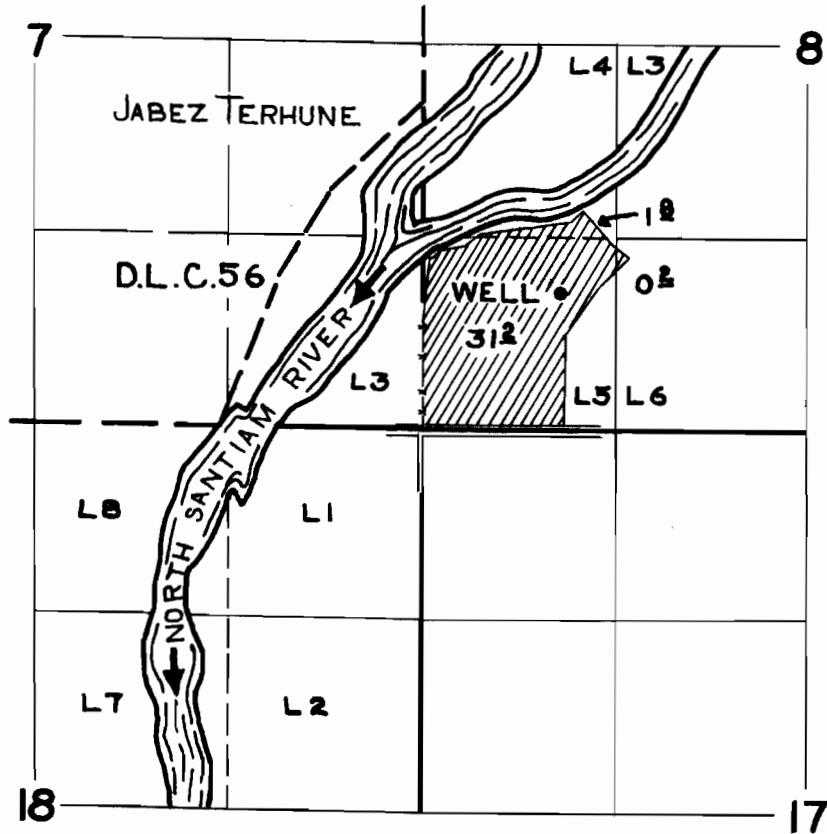

**FINAL PROOF SURVEY**  
UNDER

Application No. G.751 Permit No. G.651  
IN NAME OF

WM. UPPSTAD

Surveyed JUNE 21 1960, by M. BISH