


T.12.S.R.4.W.W.M.

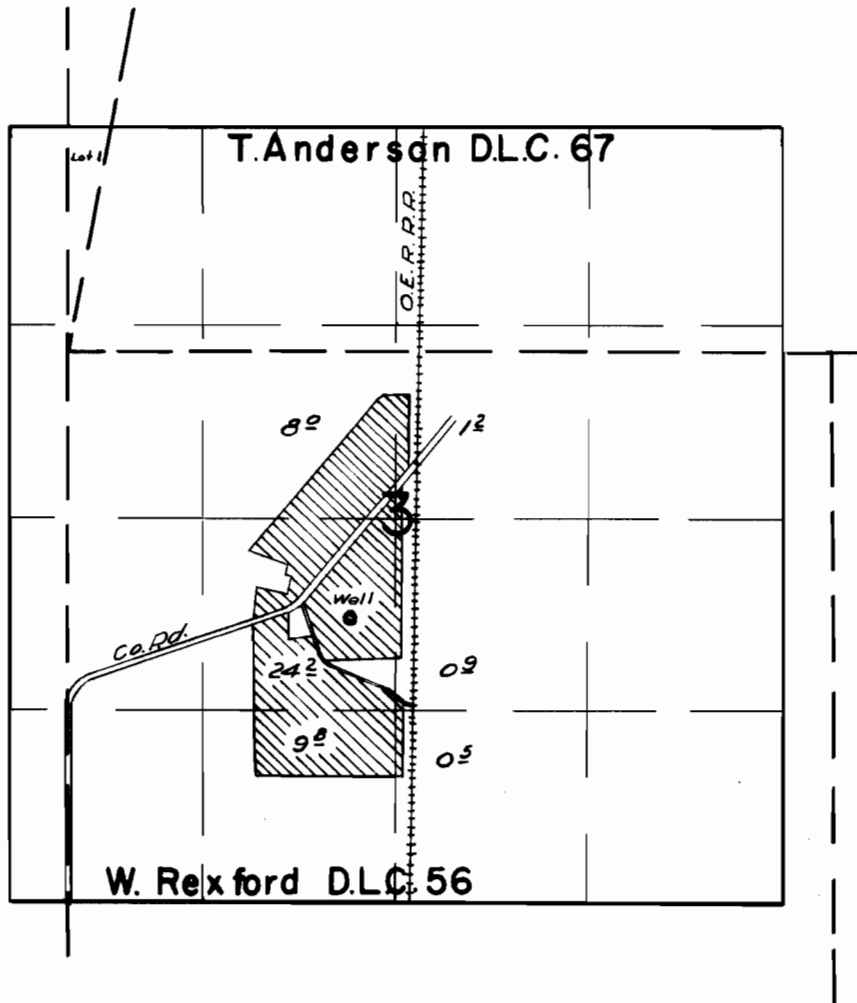

FINAL PROOF SURVEY
UNDER

Application No. *G-1071* Permit No. *G-939*
IN NAME OF

GLEN U. & RACHEL A. OHLING

Surveyed *3 AUG* 1960 by *M. Bish*