


T.14 S.R.1 W.W.M.

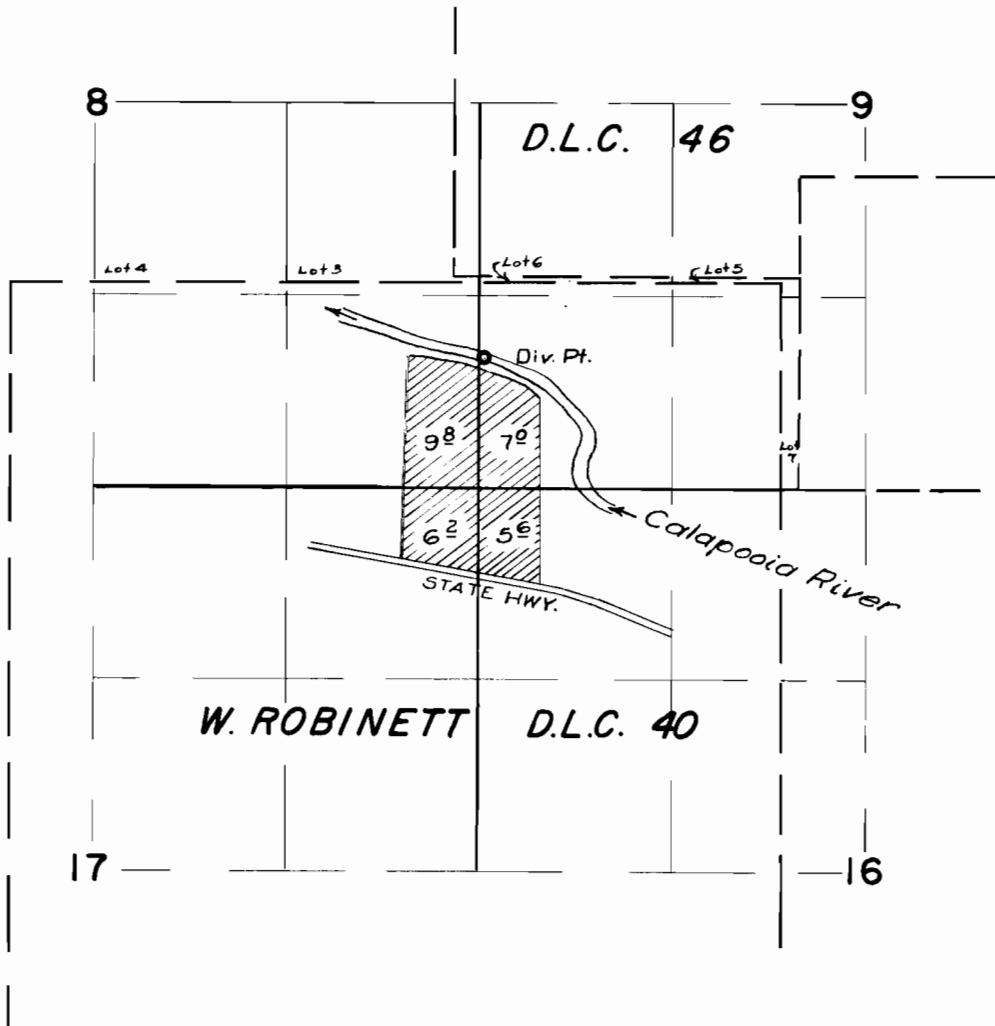

FINAL PROOF SURVEY UNDER

Application No. 27231 Permit No. 21425
IN NAME OF

MARVIN I. ELLER

Surveyed 5 Aug. 1960, by Mr. Bish