


T.14 S.R.4 & 5 W.W.M.

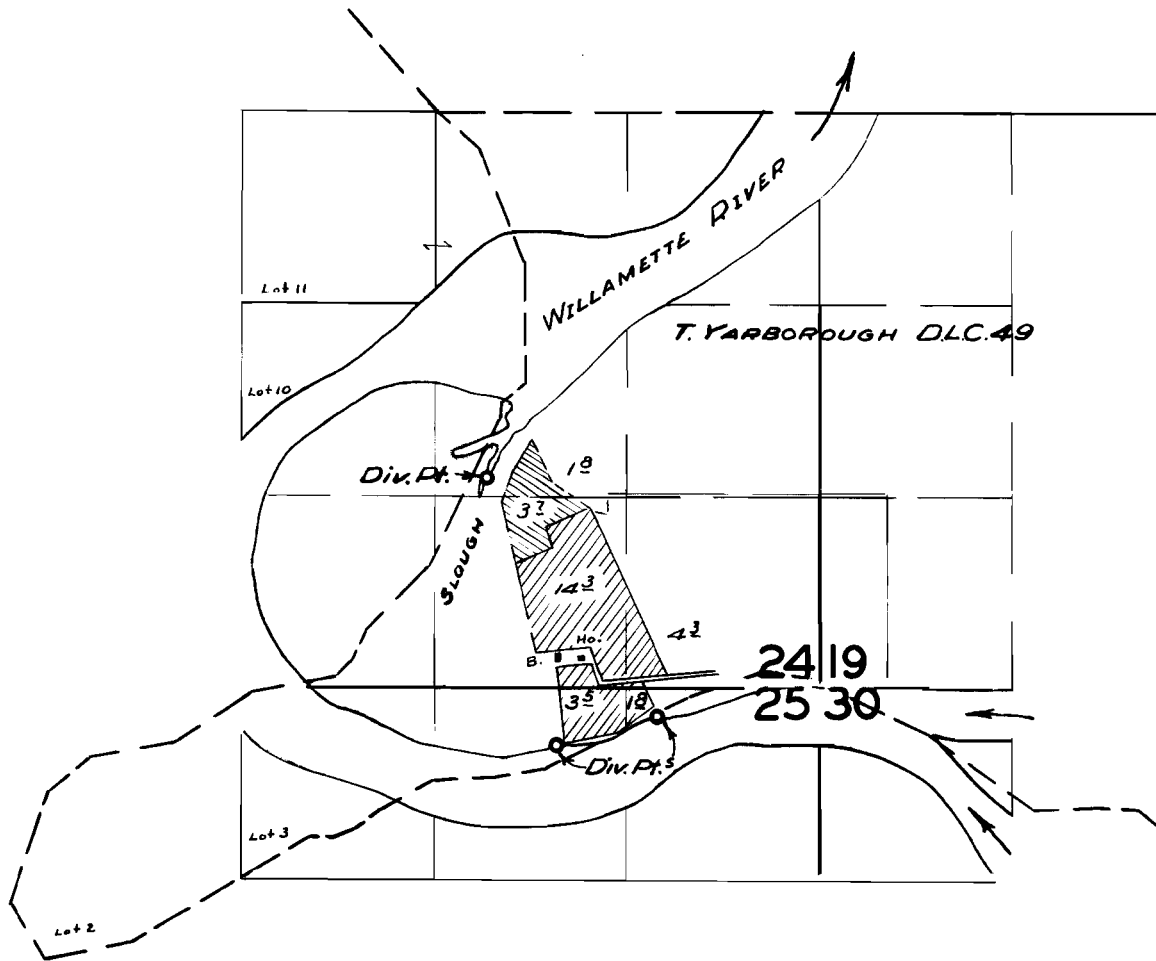

FINAL PROOF SURVEY UNDER

Application No. 28936 Permit No. 22721
IN NAME OF

ELMER & LILLIAN SKILES

Surveyed 2 AUG. 1960, by M. B. Bish