


# T.12 S.R.1 & 2 W.W.M.

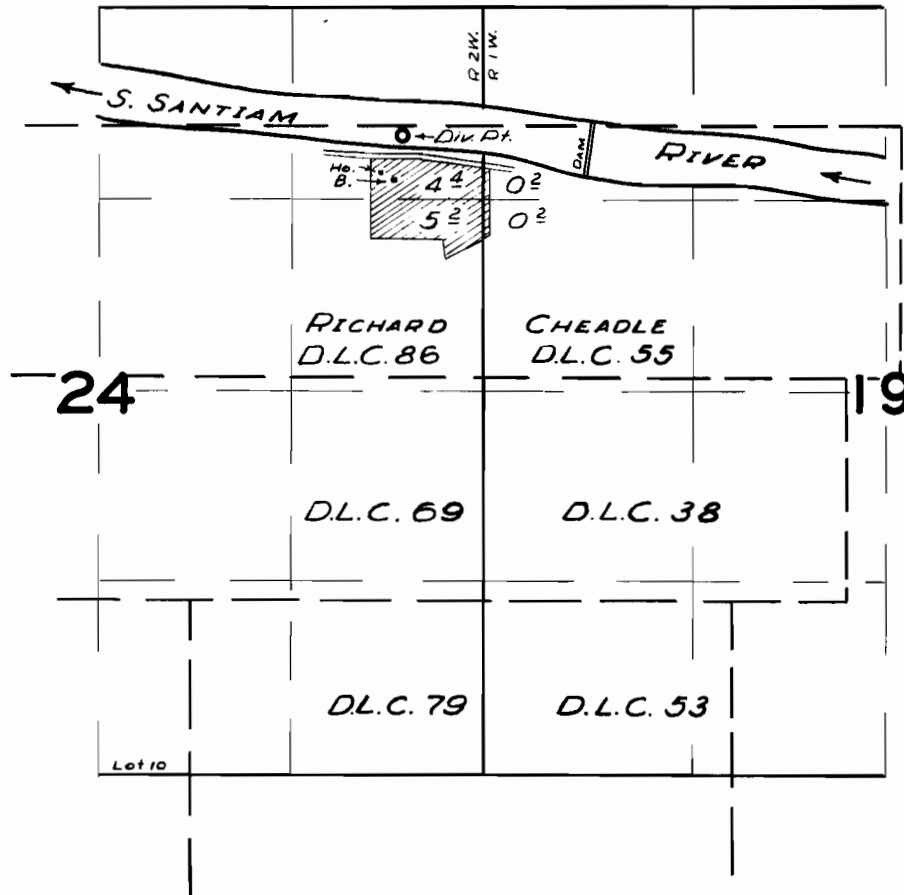

## FINAL PROOF SURVEY UNDER

Application No. 31586 Permit No. 24919  
IN NAME OF

CARL L. MORRISON

2 SEPT. 1959 P. H. JACKSON  
Surveyed 13 MAY. 1960 by Mr. O. S. [Signature]