


T.10S. R. 2W.W.M.

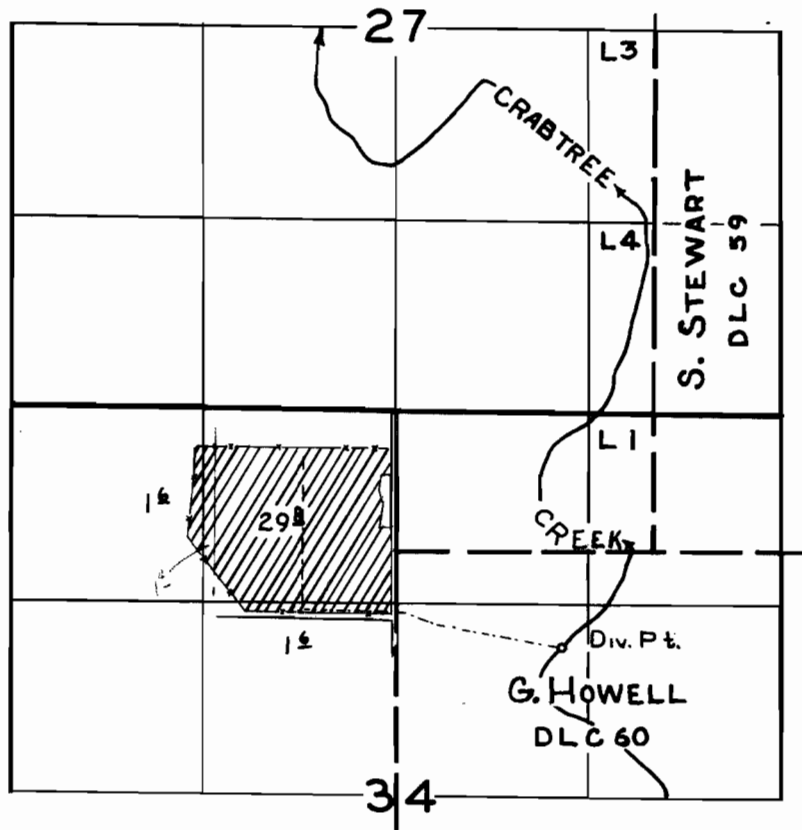

FINAL PROOF SURVEY
UNDER

Application No. 32890... Permit No. 25972....
IN NAME OF

.....**DARRELL C. SHEPHERD**.....

Surveyed JULY 5 1960, by M. BISH.....