


T. 9S. R. 1E. W.M.

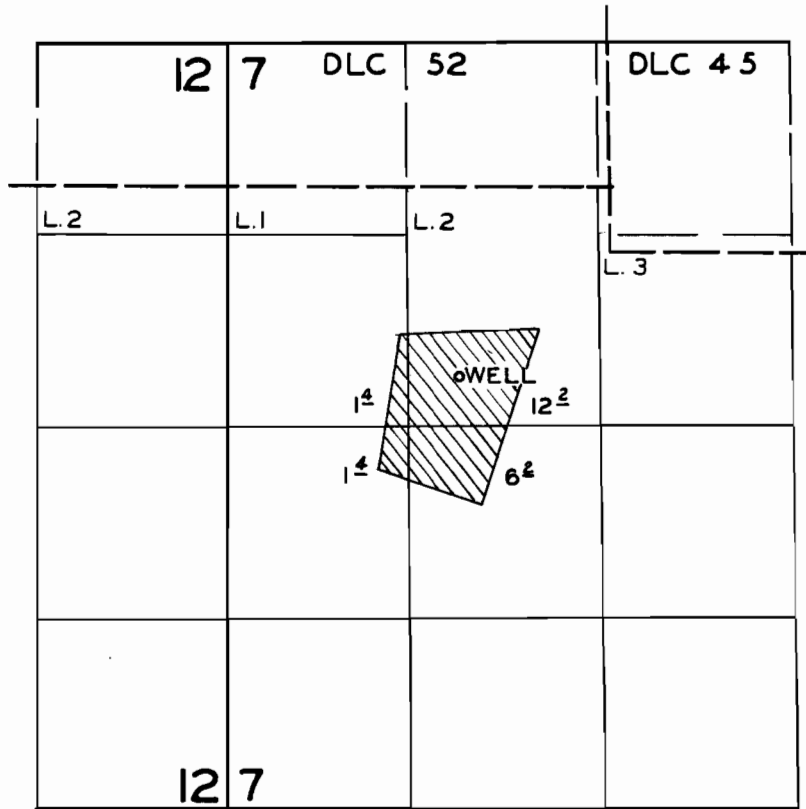

FINAL PROOF SURVEY
UNDER

Application No. G.153 Permit No. G.78
IN NAME OF

ANGUS L. & MARCILLE D. WARE

Surveyed JUNE 9 59 by C.O. BARTELS
MARCH 28 19 60, by M. BISH