


T. 5S. R. 2W. W.M.

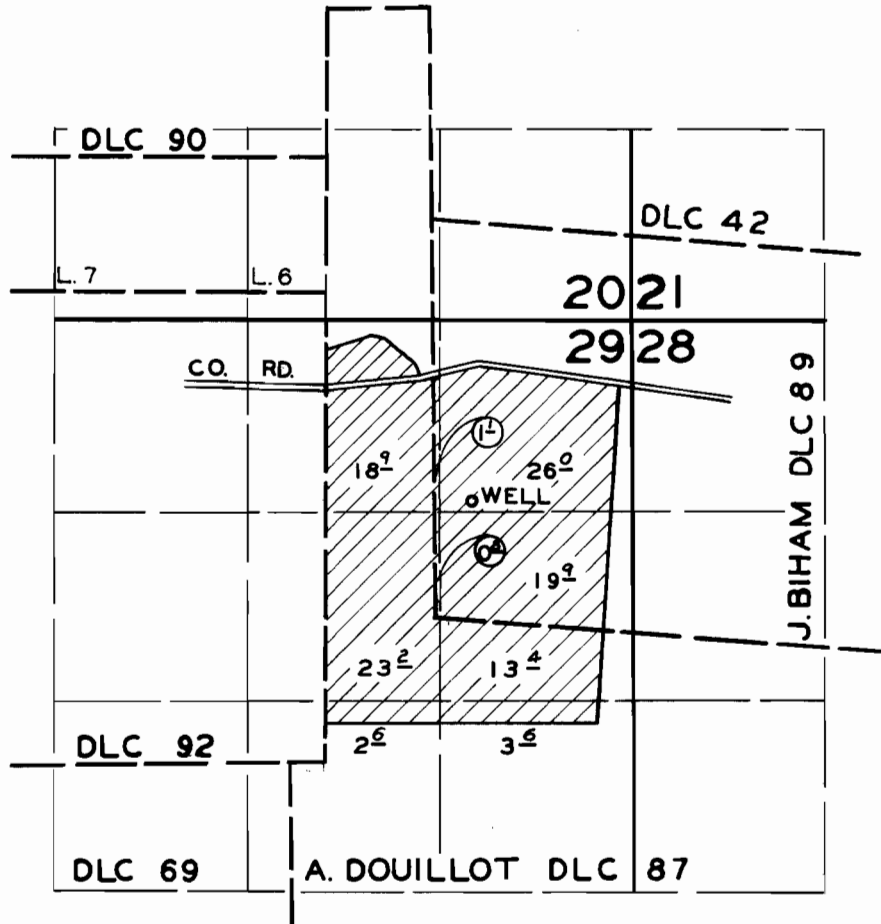

**FINAL PROOF SURVEY**  
UNDER

Application No. G 244 Permit No. G 159  
IN NAME OF

**LOUIS SCHMERBER**

Surveyed JUNE 3 19.60, by C.O. BARTELS