


T. 6S. R. 1W. W.M.

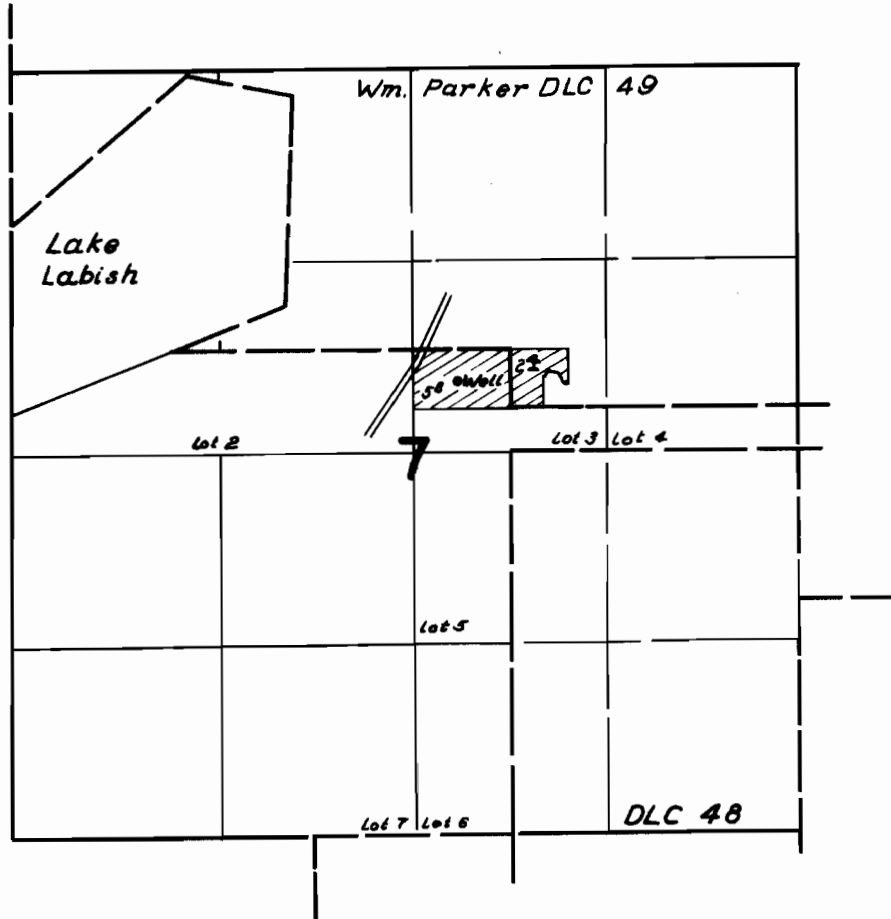

FINAL PROOF SURVEY UNDER

Application No. *G433* Permit No. *G307*
IN NAME OF

William Uppendahl

Surveyed *May 27 1959*, by *C.O. Bartels*