


T. 5S. R. 2W. W.M.

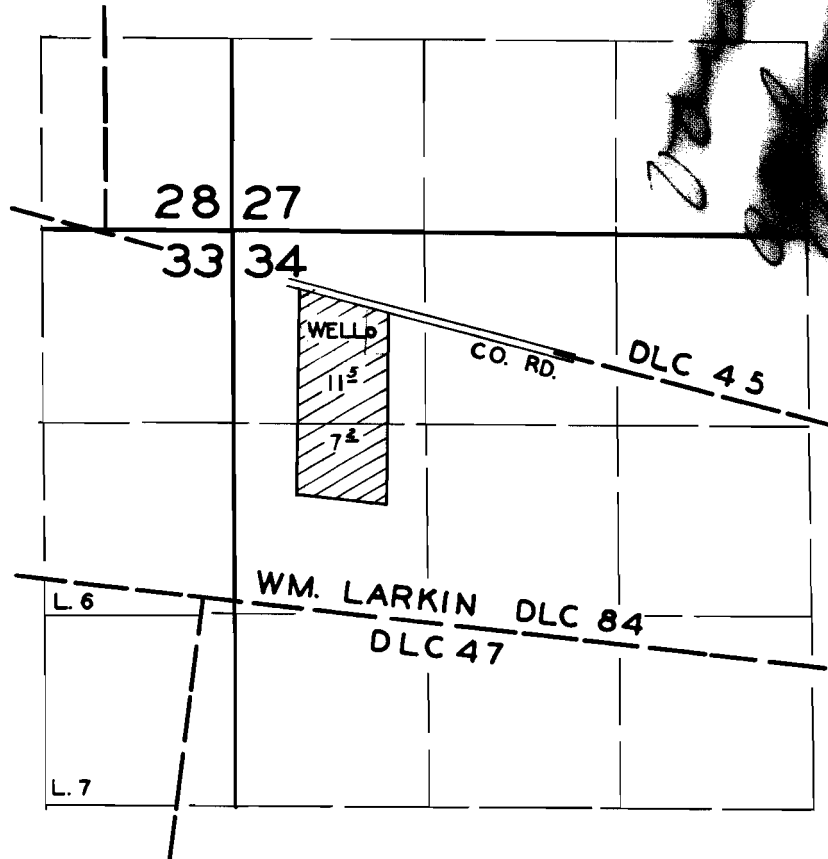

FINAL PROOF SURVEY
UNDER

Application No. G.564..... Permit No. G.459.....
IN NAME OF

..... K.A. & HAZEL BANKS

Surveyed MAY 23 1960, by C.O. BARTELS