


T. 9S. R. 1W. W.M.

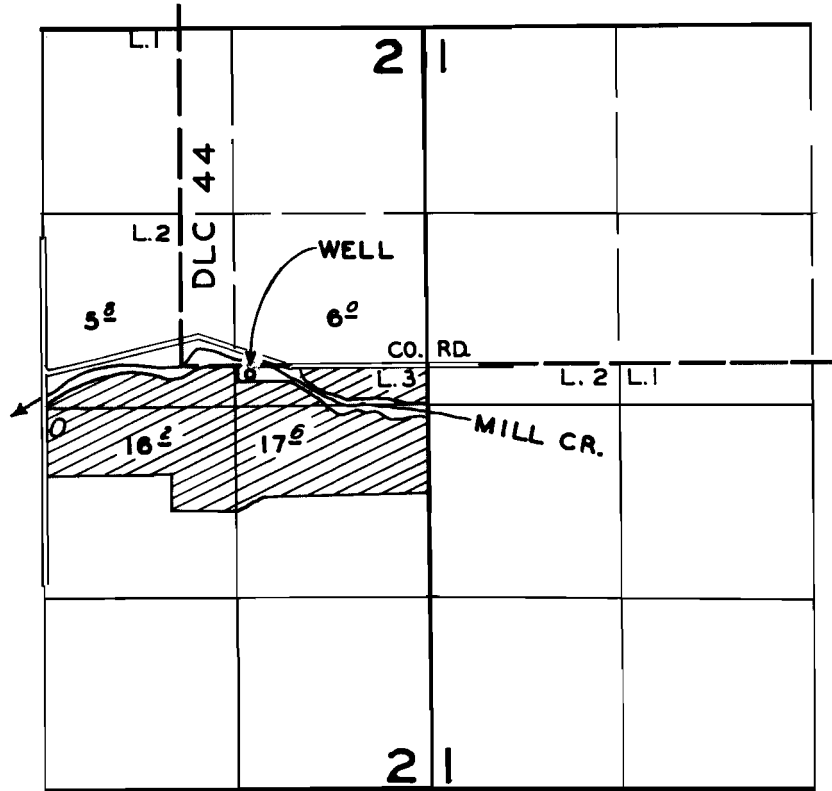

FINAL PROOF SURVEY
UNDER

Application No. G 568 Permit No. G 490.....
IN NAME OF

..... ALOIS HASSLER

Surveyed MAY 16 1960., by G. O. BARTELS.....