


T. 6S. R. 1W. W.M.

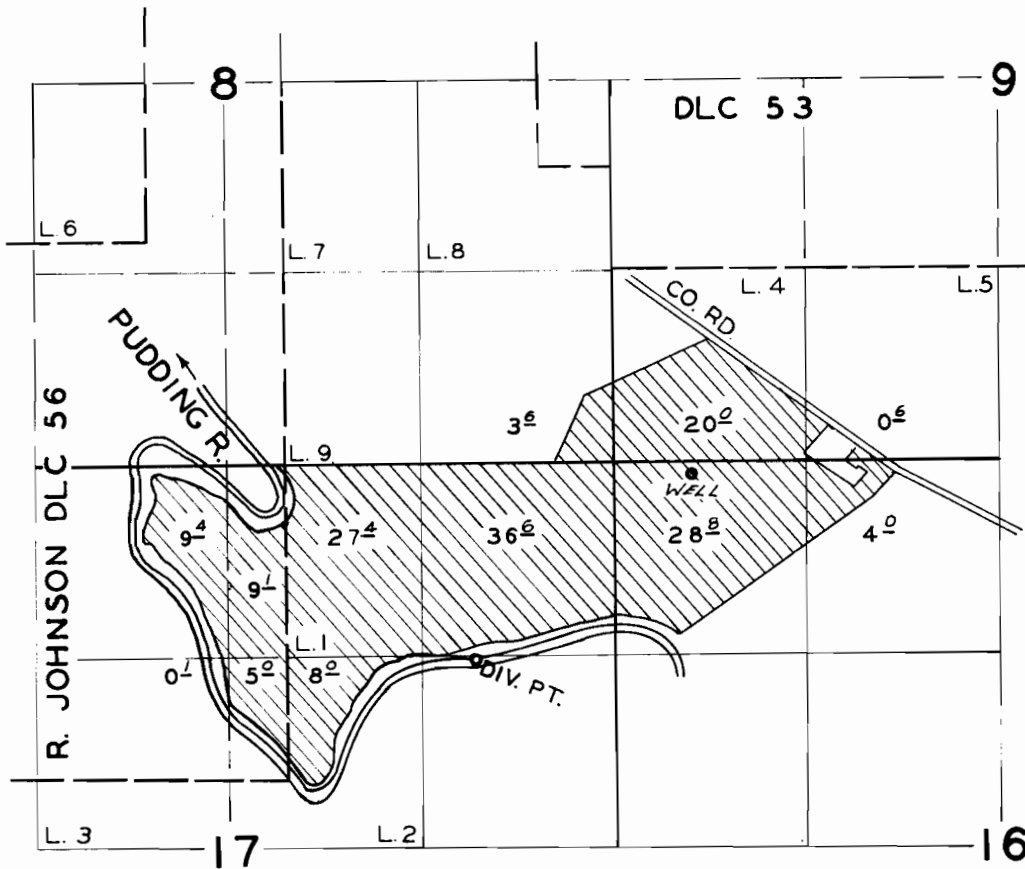

FINAL PROOF SURVEY UNDER

Application No. 27187..... Permit No. 21522.....
IN NAME OF

JOSEPH KIRSCH

Surveyed JUNE 3, 1960, by C. O. BARTELS.....