


T. 7S. R. IW. W.M.

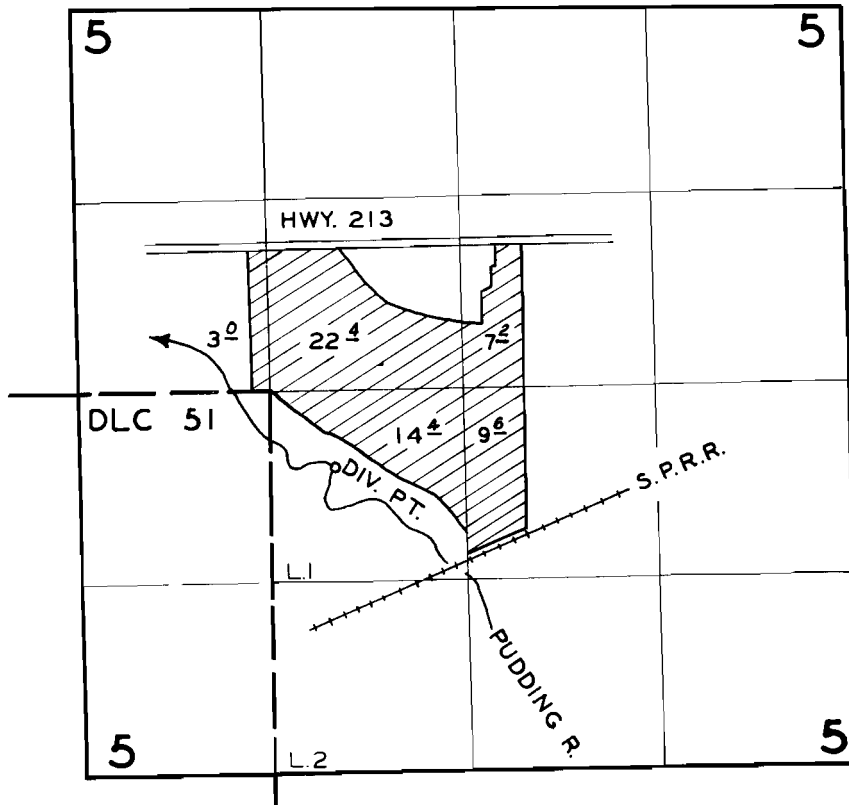

**FINAL PROOF SURVEY**  
UNDER

Application No. 31041 Permit No. 24540  
IN NAME OF

**ALVIN KRUG**

Surveyed JUNE 2 1960, by C.O. BARTELS.