


T. 15. R. 4E. W.M.

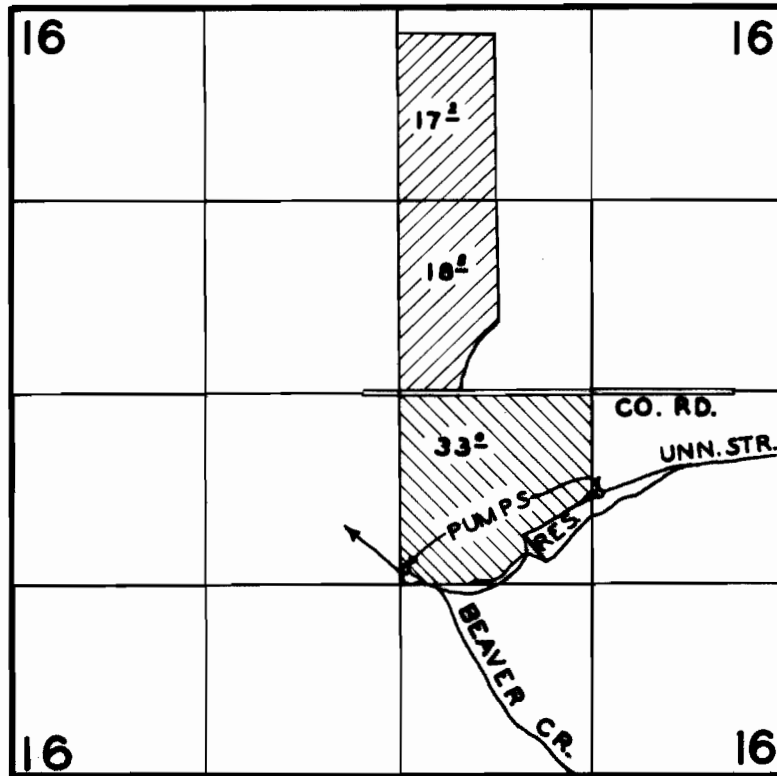

FINAL PROOF SURVEY
UNDER

R 28620 R 1616
28621 22896
Application No. 31164 Permit No. 24501



IN NAME OF

..... WILLIAM H. SESTER

Surveyed MAY 10, 1960, by C. O. BARTELS