T. 1S. R. 4E. W.M.

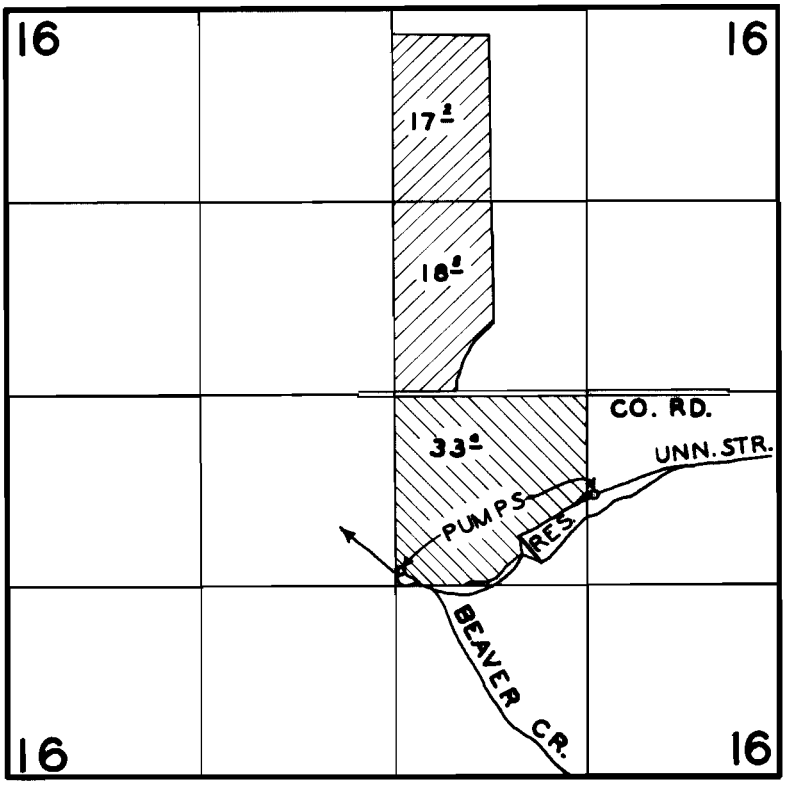

FINAL PROOF SURVEY
UNDER

R 28620 R 1616
28621 22896
Application No. 31164 Permit No. 24561

IN NAME OF

WILLIAM H. SESTER

Surveyed MAY 10 1960, by C. O. BARTELS

DFD-40-09 f 1960 ✓ L.J.