



T. 1S. R. 4E. W.M.

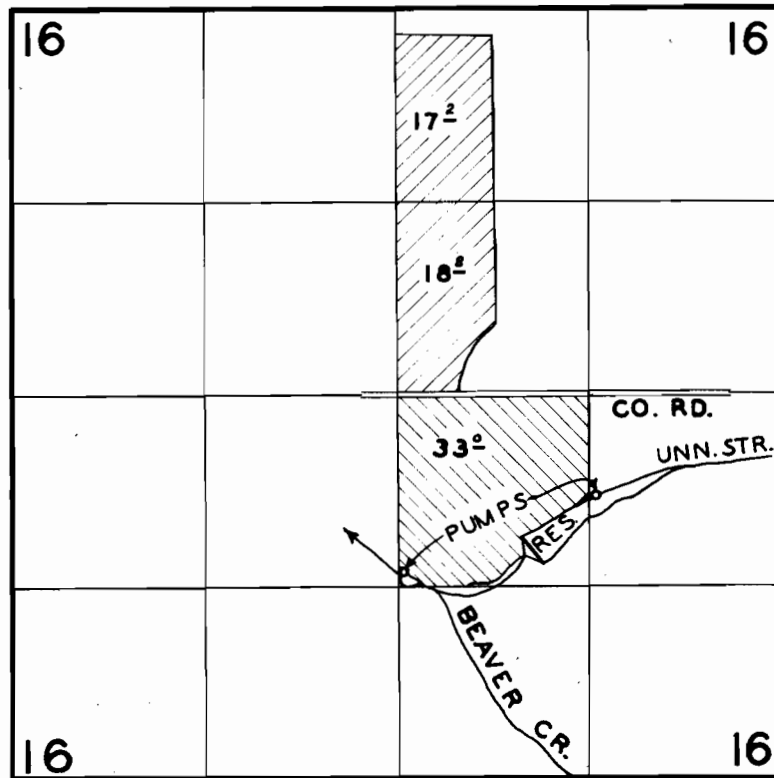

FINAL PROOF SURVEY UNDER

R 28620 R 1616
 28621 22896
 Application No. 31164 Permit No. 24561

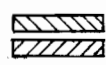

IN NAME OF

WILLIAM H. SESTER

Surveyed MAY 10, 1960, by C. O. BARTELS