


T. 8 S. R. 4 W. W. M.

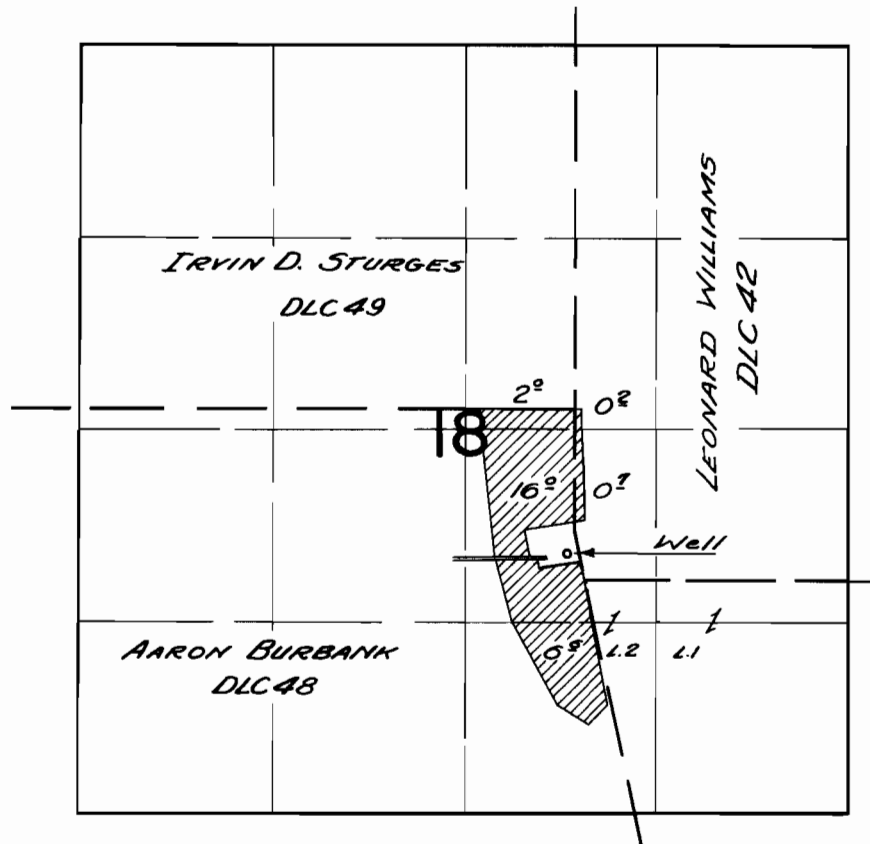

FINAL PROOF SURVEY
UNDER

Application No. G-583 Permit No. G-480
IN NAME OF

CLYDE W. DODGE

Surveyed Aug. 17 1960, by A. O. Bartels