


T. 8S. R. 4W. W.M.

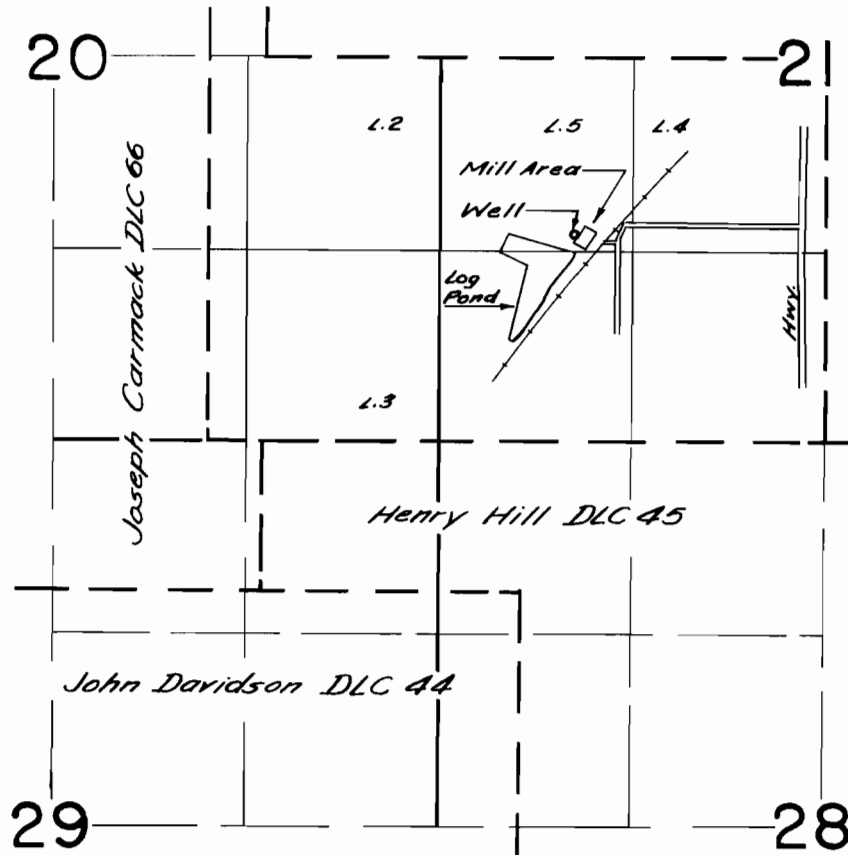

FINAL PROOF SURVEY
UNDER

Application No. *G-1213*... Permit No. *G-963*...
IN NAME OF

Interstate Shingle Co. Inc.

Surveyed *Aug. 17, 1960*, by *C.O. Swick*