


T.9S. R.6W.W.M.

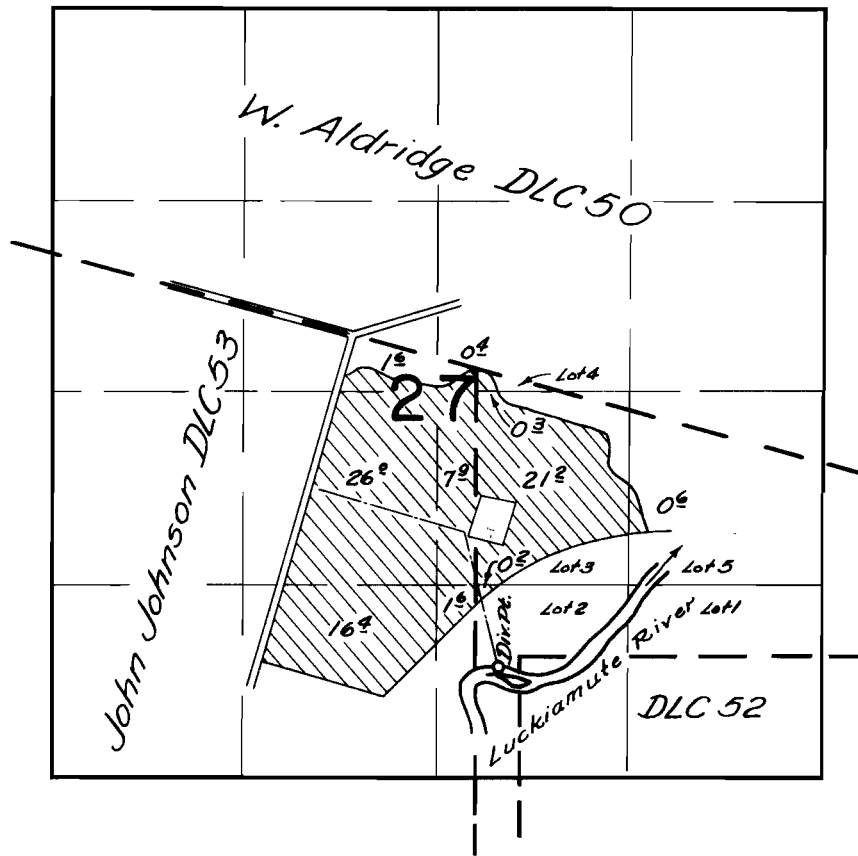

FINAL PROOF SURVEY
UNDER

Application No. 18706 Permit No. 14329
IN NAME OF

ARTHUR C. & VERA O. KORN 1

60
Surveyed Aug. 16, 1976 by C. O. Baer