


T.6 S. R. 4W.W.M.

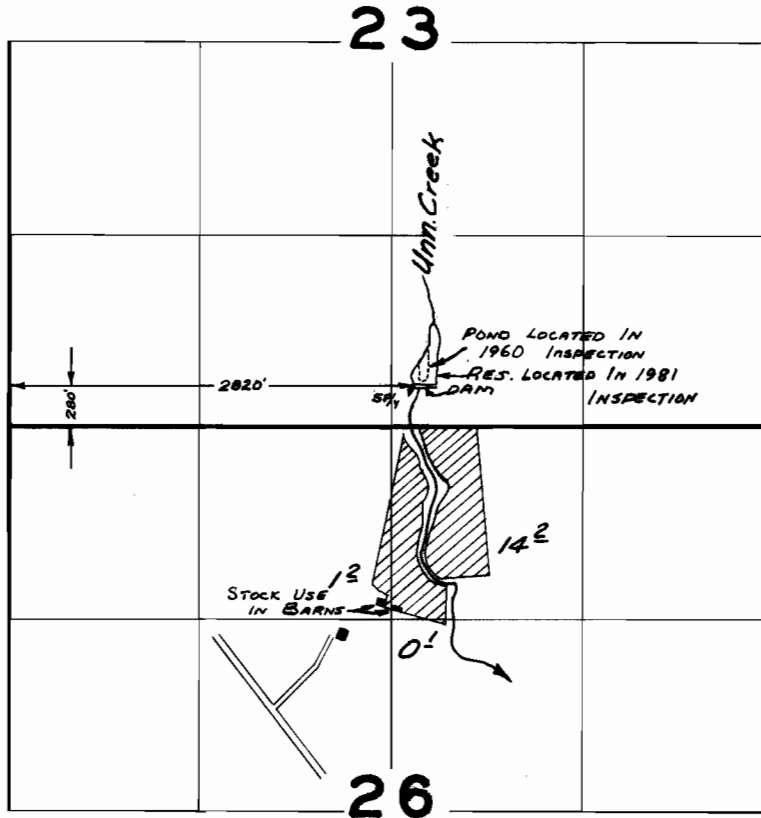

**FINAL PROOF SURVEY  
UNDER**

R-59293

R-8132

59294

44869

Application No. 29292... Permit No. 23026...  
IN NAME OF

*NORMAN L. RICE*

Surveyed *June 20, 1960*, by *C. O. Bartlett*

*November 10, 1981* L. M. TOLL