


T.6S.R.7W.W.M.

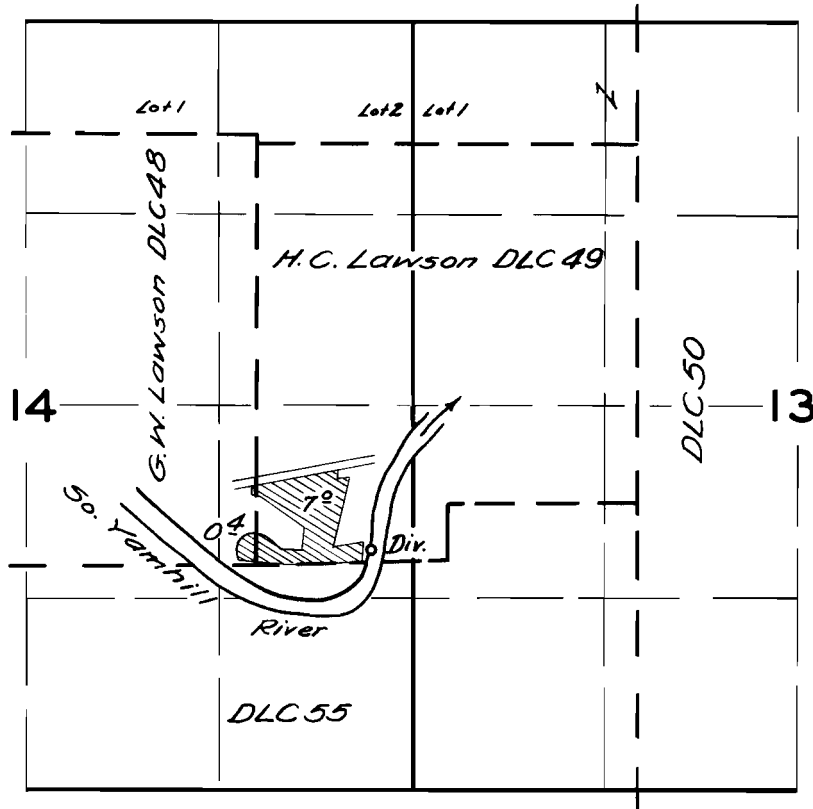

FINAL PROOF SURVEY
UNDER

Application No. 30155 Permit No. 23792
IN NAME OF

FRED S. WOOD

Surveyed June 22 1960, by C. B. Bartels