


T. 6 S. R. 5 W. W. M.

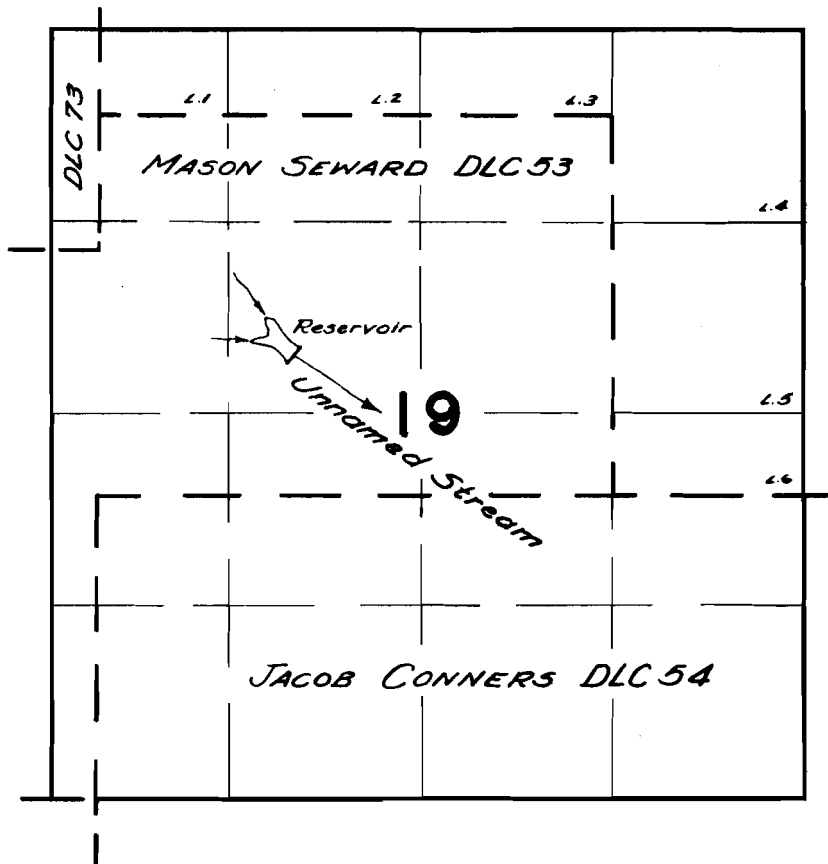

FINAL PROOF SURVEY UNDER

Application No. *R-30909* Permit No. *R-1908*
30910 *24412*
IN NAME OF

Chester & Carl Dodson

Surveyed *June 23* 19*60*, by *C.O. Butts*