


T.6S. R. 4W.W.M.

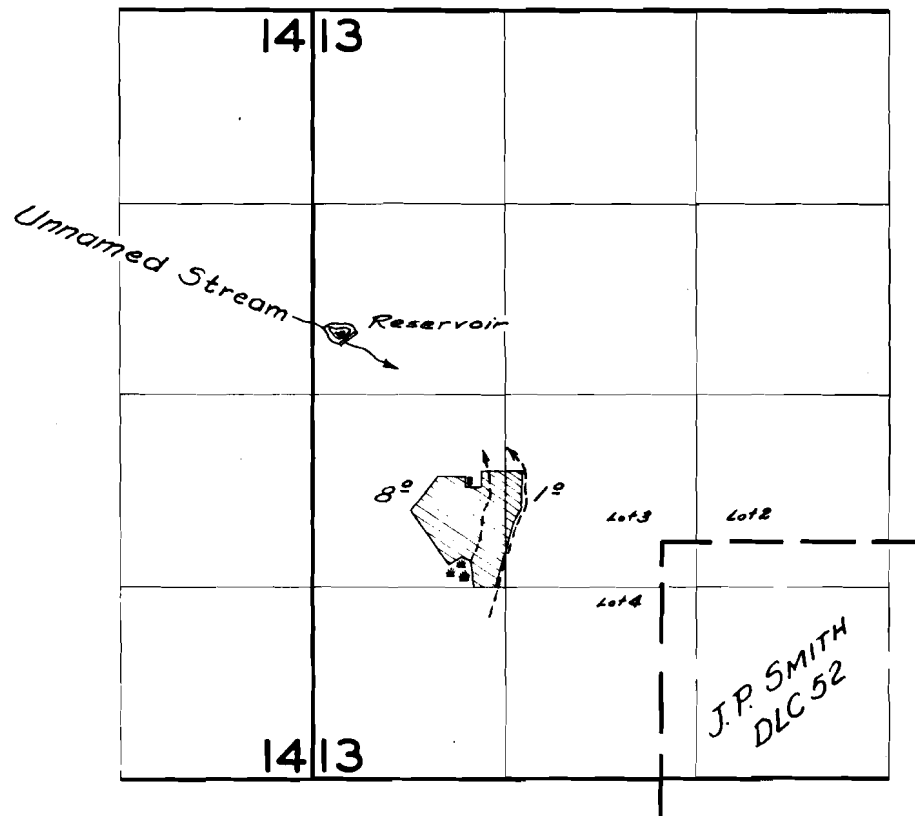

FINAL PROOF SURVEY  
UNDER

Application No. *R-31018* 31019 Permit No. *R-1922* 24453  
IN NAME OF

*GEORGE Hammond*

Surveyed *June 21, 1960*, by *C.O. Bartels*